


• - INDICATES IRON PIPE.

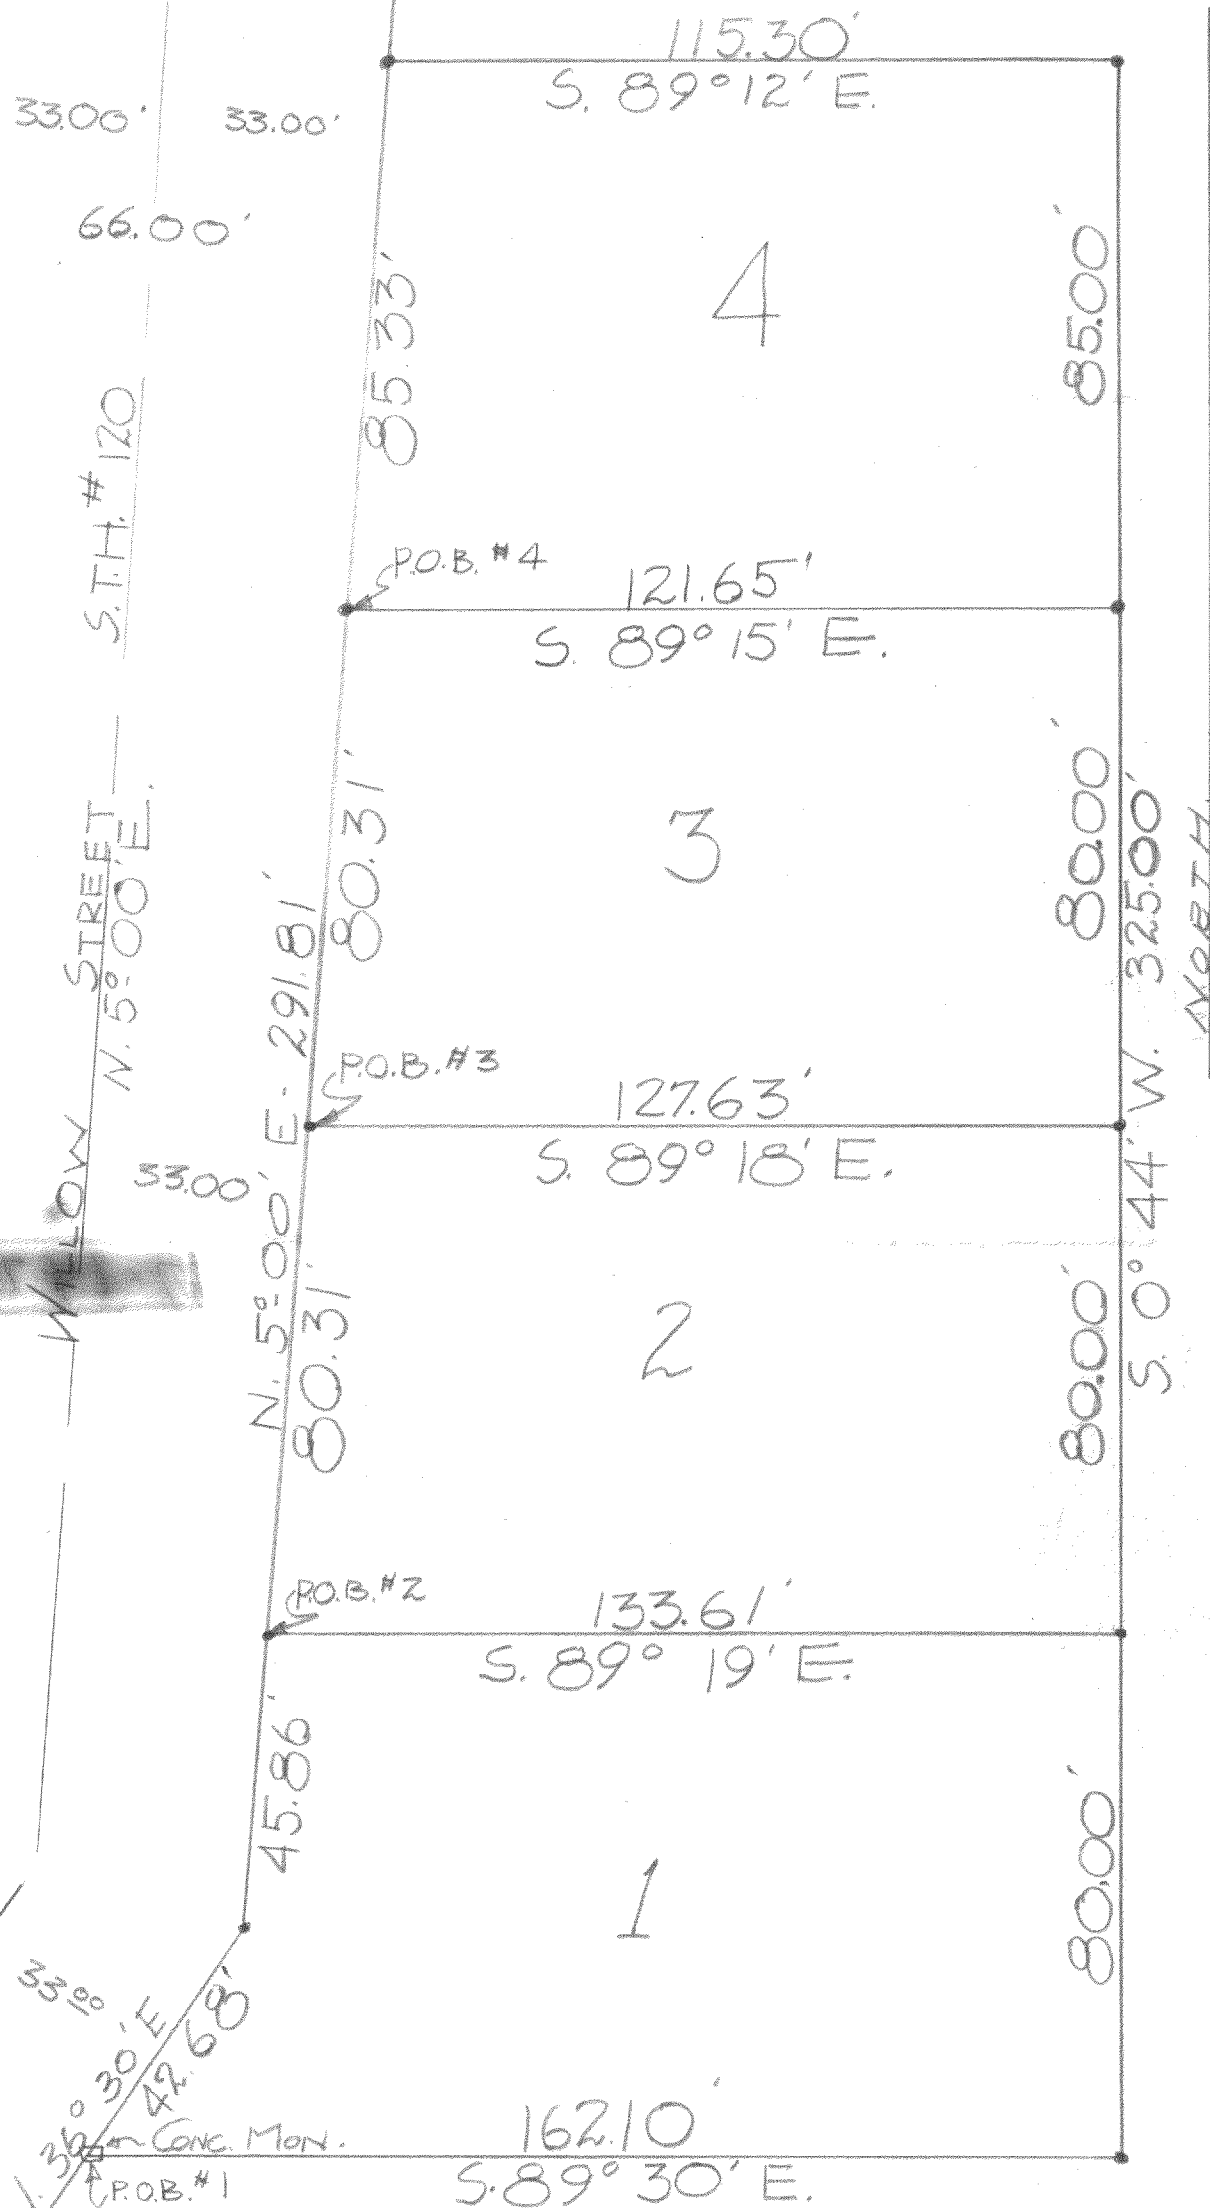

DESCRIPTIONS:

PARCEL #1. Commencing at a point that is 2588.03 feet west of and 1047.75 feet north of the east quarter corner, of Section 1, Town 1, north, Range 17 east, City of Lake Geneva, Walworth County, Wisconsin, thence N. 36° 30' E., along the east line of Willow Street, 42.68 feet, thence N. 5° 00' E., 45.86 feet, thence S. 89° 19' E., 133.61 feet, thence S. 00° 44' W., 80.00 feet, thence N. 89° 30' W., 162.10 feet to the place of beginning.

PARCEL #2. Commencing at a point that is 2588.03 feet west of and 1047.75 feet north of the east quarter corner, of Section 1, Town 1, north, Range 17 east, City of Lake Geneva, Walworth County, Wisconsin, thence N. 36° 30' E., along the east line of Willow Street, 42.68 feet, thence N. 5° 00' E., 45.86 feet, to the place of beginning of the lands hereinafter described, thence N. 5° 00' E., along the east line of said street, 80.31 feet, thence S. 89° 18' E., 127.63 feet, thence S. 00° 44' W., 80.00 feet, thence N. 89° 19' W., 133.61 feet to the place of beginning.

PARCEL #3. Commencing at a point that is 2588.03 feet west of and 1047.75 feet north of the east quarter corner, of Section 1, Town 1, north Range 17, east, City of Lake Geneva, Walworth County, Wisconsin, thence N. 36° 30' E., along the east line of Willow Street, 42.68 feet, thence N. 5° 00' E., 126.17 feet to the place of beginning of lands hereinafter described, thence N. 5° 00' E., along the east line of said street, 80.31 feet, thence S. 89° 15' E., 121.65 feet, thence S. 00° 44' W., 80.00 feet, thence N. 89° 18' W., 127.63 feet to the place of beginning.

PARCEL #4. Commencing at a point that is 2588.03 feet west of and 1047.75 feet north of the east quarter corner, of Section 1, Town 1, north, Range 17, east, City of Lake Geneva, Walworth County, Wisconsin, thence N. 36° 30' E., along the east line of Willow Street, 42.68 feet, thence N. 5° 00' E., 206.48 feet to the place of beginning of lands hereinafter described, thence N. 5° 00' E., along the east line of said street 85.33 feet, thence S. 89° 12' E., 115.30 feet, thence S. 0° 44' W., 85.00 ft., thence N. 89° 15' W., 121.65 ft. to the place of beginning.

CERTIFICATE:

I, James F. Biagi, surveyor, do hereby that I have surveyed the lands hereon described and portrayed, on the 17th day of April, 1961.
 SIGNED AND SEALED ON THIS THE 19TH DAY OF APRIL 1961.

James F. Biagi, R.L.S. 272
 Elkhorn, Wisconsin.

7-147B