



BOUNDARY & TOPOGRAPHIC SURVEY

UNIT 1 LONGWOOD CONDOMINIUM



LOCATED IN THE SE 1/4 OF SECTION 36,
TOWN 2 NORTH, RANGE 17 EAST, CITY OF
LAKE GENEVA, WALWORTH COUNTY, WISCONSIN

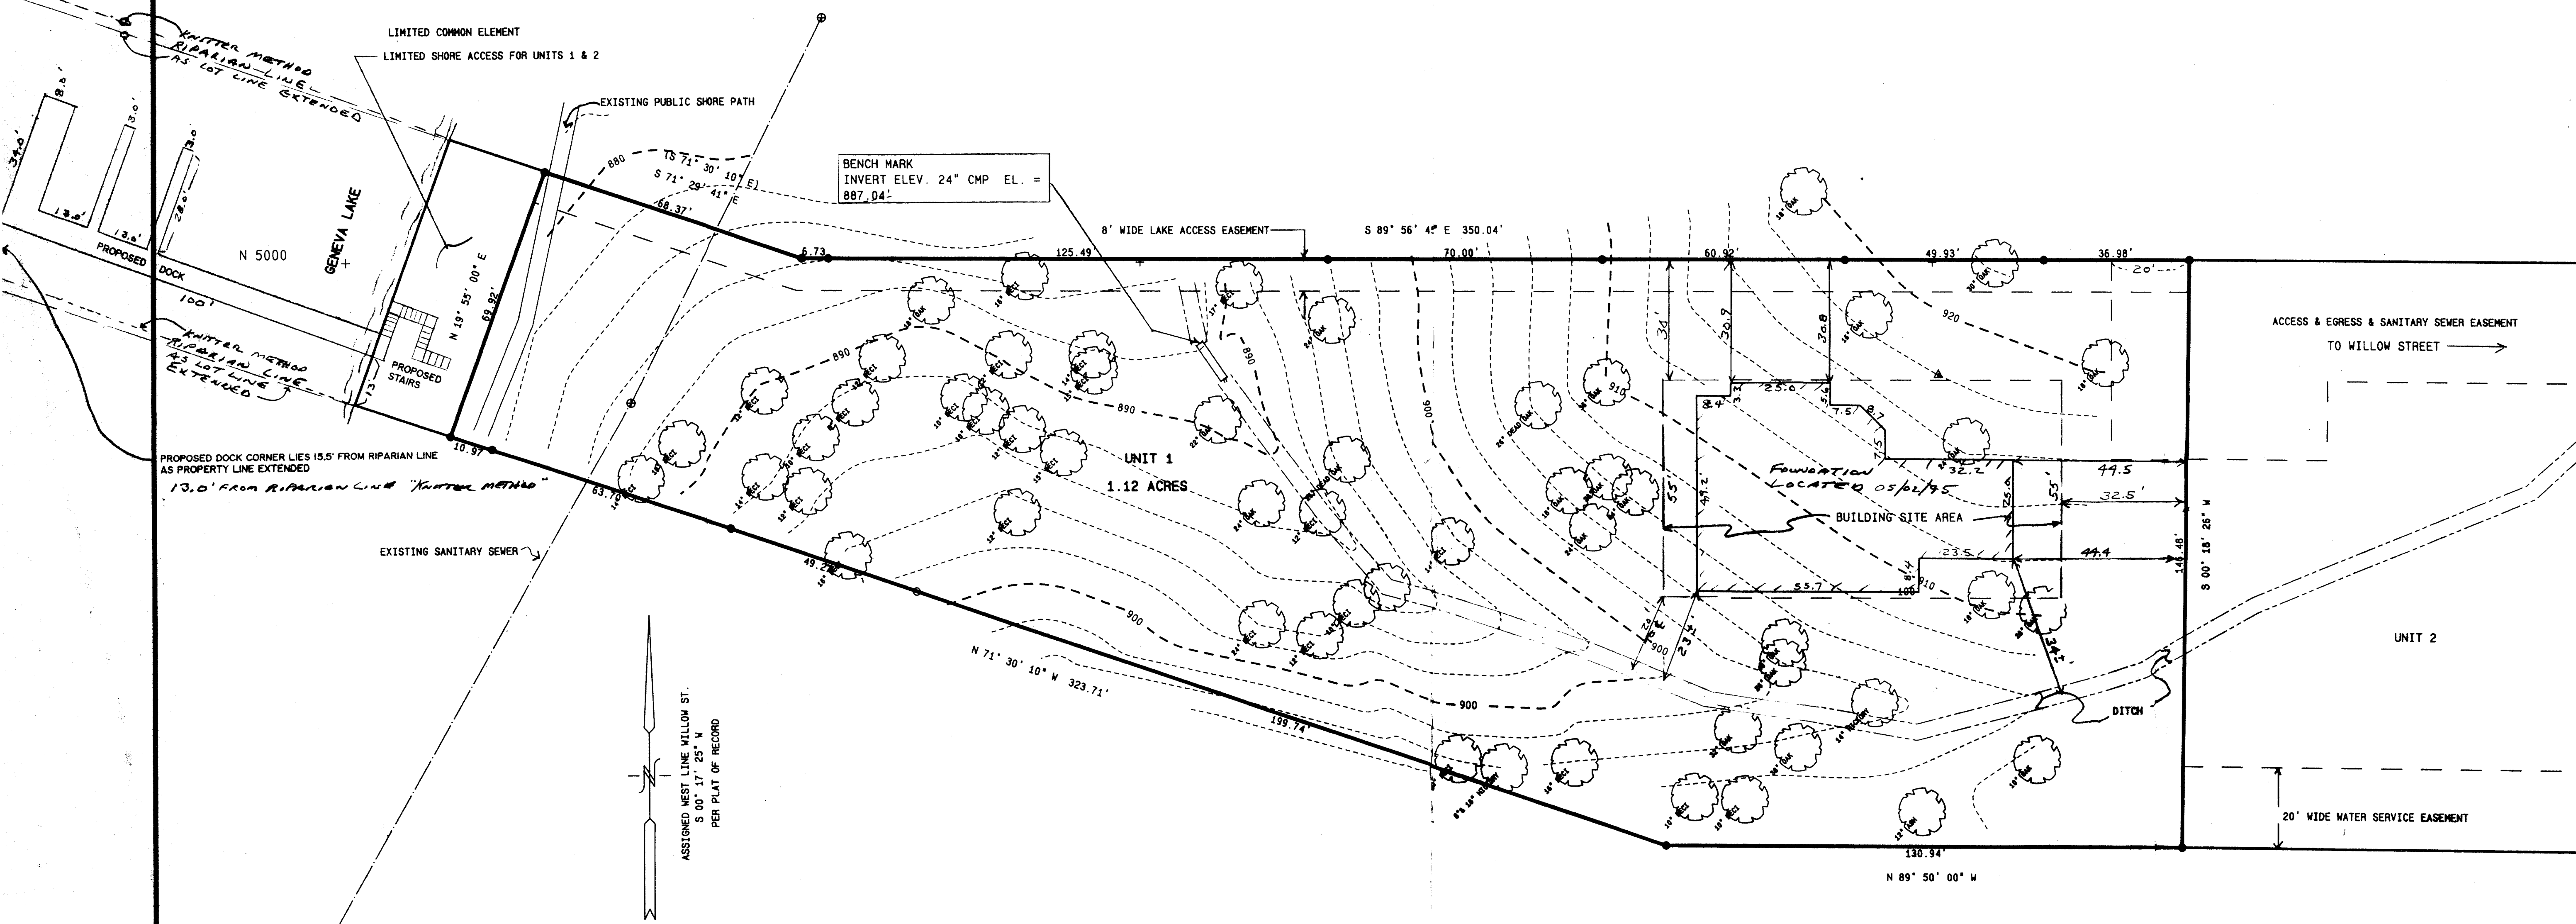

ASSIGNED WEST LINE WILLOW ST.
S 00° 17' 25" W
PER PLAT OF RECORD

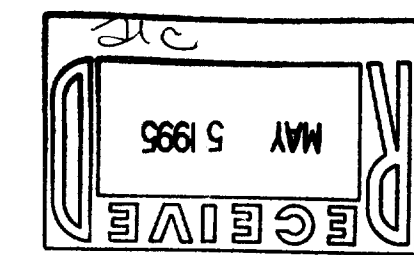

- LEGEND
- = FOUND IRON REBAR STAKE
 - = FOUND IRON PIPE STAKE
 - ⊗ = SANITARY SEWER MANHOLE
 - △ = WATER CURB STOP BOX
 - (red) = RECORDED AS

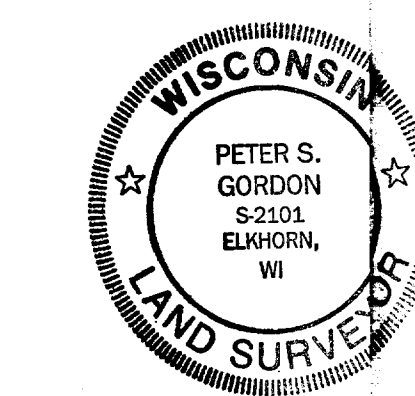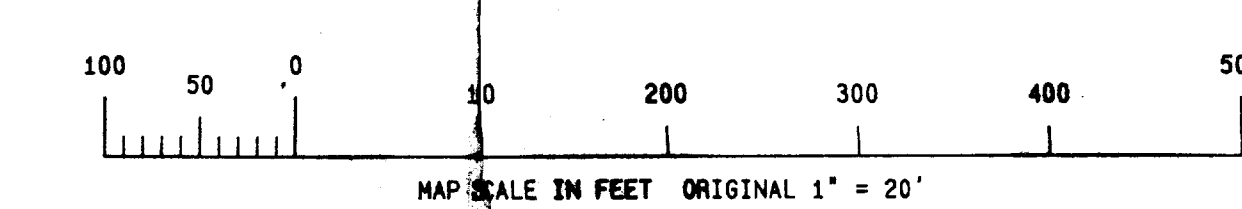

NOTE: COPIES OF THIS MAP TO WHICH THE FOLLOWING
CERTIFICATE WILL APPLY ARE BLUE LINE PRINTS SHOWING
SURVEYOR'S ORIGINAL SEAL AND SIGNATURE IN BLACK INK.
COPIES BY ANY OTHER MEANS MAY HAVE ALTERATIONS WHICH DO
NOT REPRESENT THE SURVEYOR'S WORK PRODUCT.

I HEREBY CERTIFY THAT THE ABOVE DESCRIBED PROPERTY HAS
BEEN SURVEYED UNDER MY DIRECTION AND THAT THE ABOVE MAP
IS A TRUE REPRESENTATION THEREOF AND SHOWS THE SIZE AND
LOCATION OF THE PROPERTY AND ITS EXTERIOR BOUNDARIES.
THIS SURVEY IS MADE FOR THE USE OF THE PRESENT OWNERS
OF THE PROPERTY, AND ALSO THOSE WHO PURCHASE, MORTGAGE,
OR GUARANTEE THE TITLE THERETO WITHIN ONE YEAR FROM THE
DATE HEREOF.

DATED: 02/01/95
REVISED 2/17/95 TO CORRECT LOCATION
OF BUILDING SITE AREA
REVISED 04/12/95 TO SHOW LOCATION OF PROPOSED DOCK & STAIRS
DATE 4/11/95
PETER S. GORDON R.L.S. 2101
REVISED 05/03/95 TO SHOW SIZE AND LOCATION
OF FOUNDATION

WORK ORDERED BY: RON MCCORMACK
FOR LEMIS DRAPER
PO BOX 498
FONTANA, WISCONSIN

FARRIS, HANSEN & ASSOCIATES, INC.
Engineering, Architecture, Surveying
7 Ridgeway Court P.O. Box 437
ELKHORN, WISCONSIN 53121
Office: (414) 723-2096
Fax: (414) 723-3886

REVISIONS	PROJECT NO.
	3952
DATE	SHEET NO.
01/31/95	1 OF 1