

ABELL
SURVEYING & MAPPING
DELAVAN, WISCONSIN 53115
414-728-6737

N



SCALE 1"=30'

LEGEND

Ø - IRON PIPE FOUND
() - RECORDED AS

NOTE 1: BEARINGS ARE REFERENCED TO
EXISTING SURVEY RECORDS.

TAX PARCEL
ZYUP-94B

NOTE 2: RIPARIAN INTEREST ZONE ON TAX PARCEL
ZYUP-94C WAS COMPUTED USING EXISTING
SURVEY RECORDS ON TAX PARCEL ZYUP-94B
AND TAX PARCEL ZYUP-94D.

TAX PARCEL
ZYUP-94C

TAX PARCEL
ZYUP-94D

GENEVA LAKE

PLAT OF SURVEY OF

RIPARIAN INTEREST ZONE AND PIER LOCATION ON
A PARCEL OF LAND LOCATED IN THE EAST 1/2 OF
SECTION 35, T2N, R17E, CITY OF LAKE GENEVA,
WALWORTH COUNTY, WISCONSIN.

ORDERED BY: GAGE MARINE CORP.
WHETLOW PIER SERVICE
P.O. BOX 220
WILLIAMS BAY, WI 53191


I, DAVID F. ABELL, DO HEREBY CERTIFY THAT I HAVE SURVEYED THE PROPERTY HEREON
DESCRIBED ACCORDING TO THE OFFICIAL RECORDS AND THAT THE PLAT HEREON IS A
CORRECT REPRESENTATION OF THE PROPERTY LINES TO THE BEST OF MY KNOWLEDGE AND
BELIEF.

David F. Abell

DAVID F. ABELL
WISCONSIN REGISTERED LAND SURVEYOR, S-1596

February 6, 1996

DATE JOB NUMBER - 95088
NOTE: THIS IS NOT A CERTIFIED COPY UNLESS SEALED.

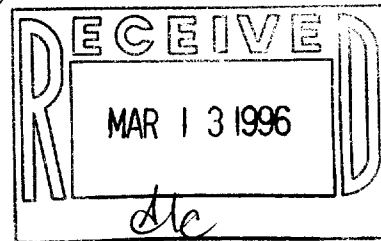

ZYUP-94C

007-16-38