


PLAT OF SURVEY

South 1/2 of Lots 120, 121, and 122, Columbian Subdivision,
City of Lake Geneva, Walworth County, Wisconsin.

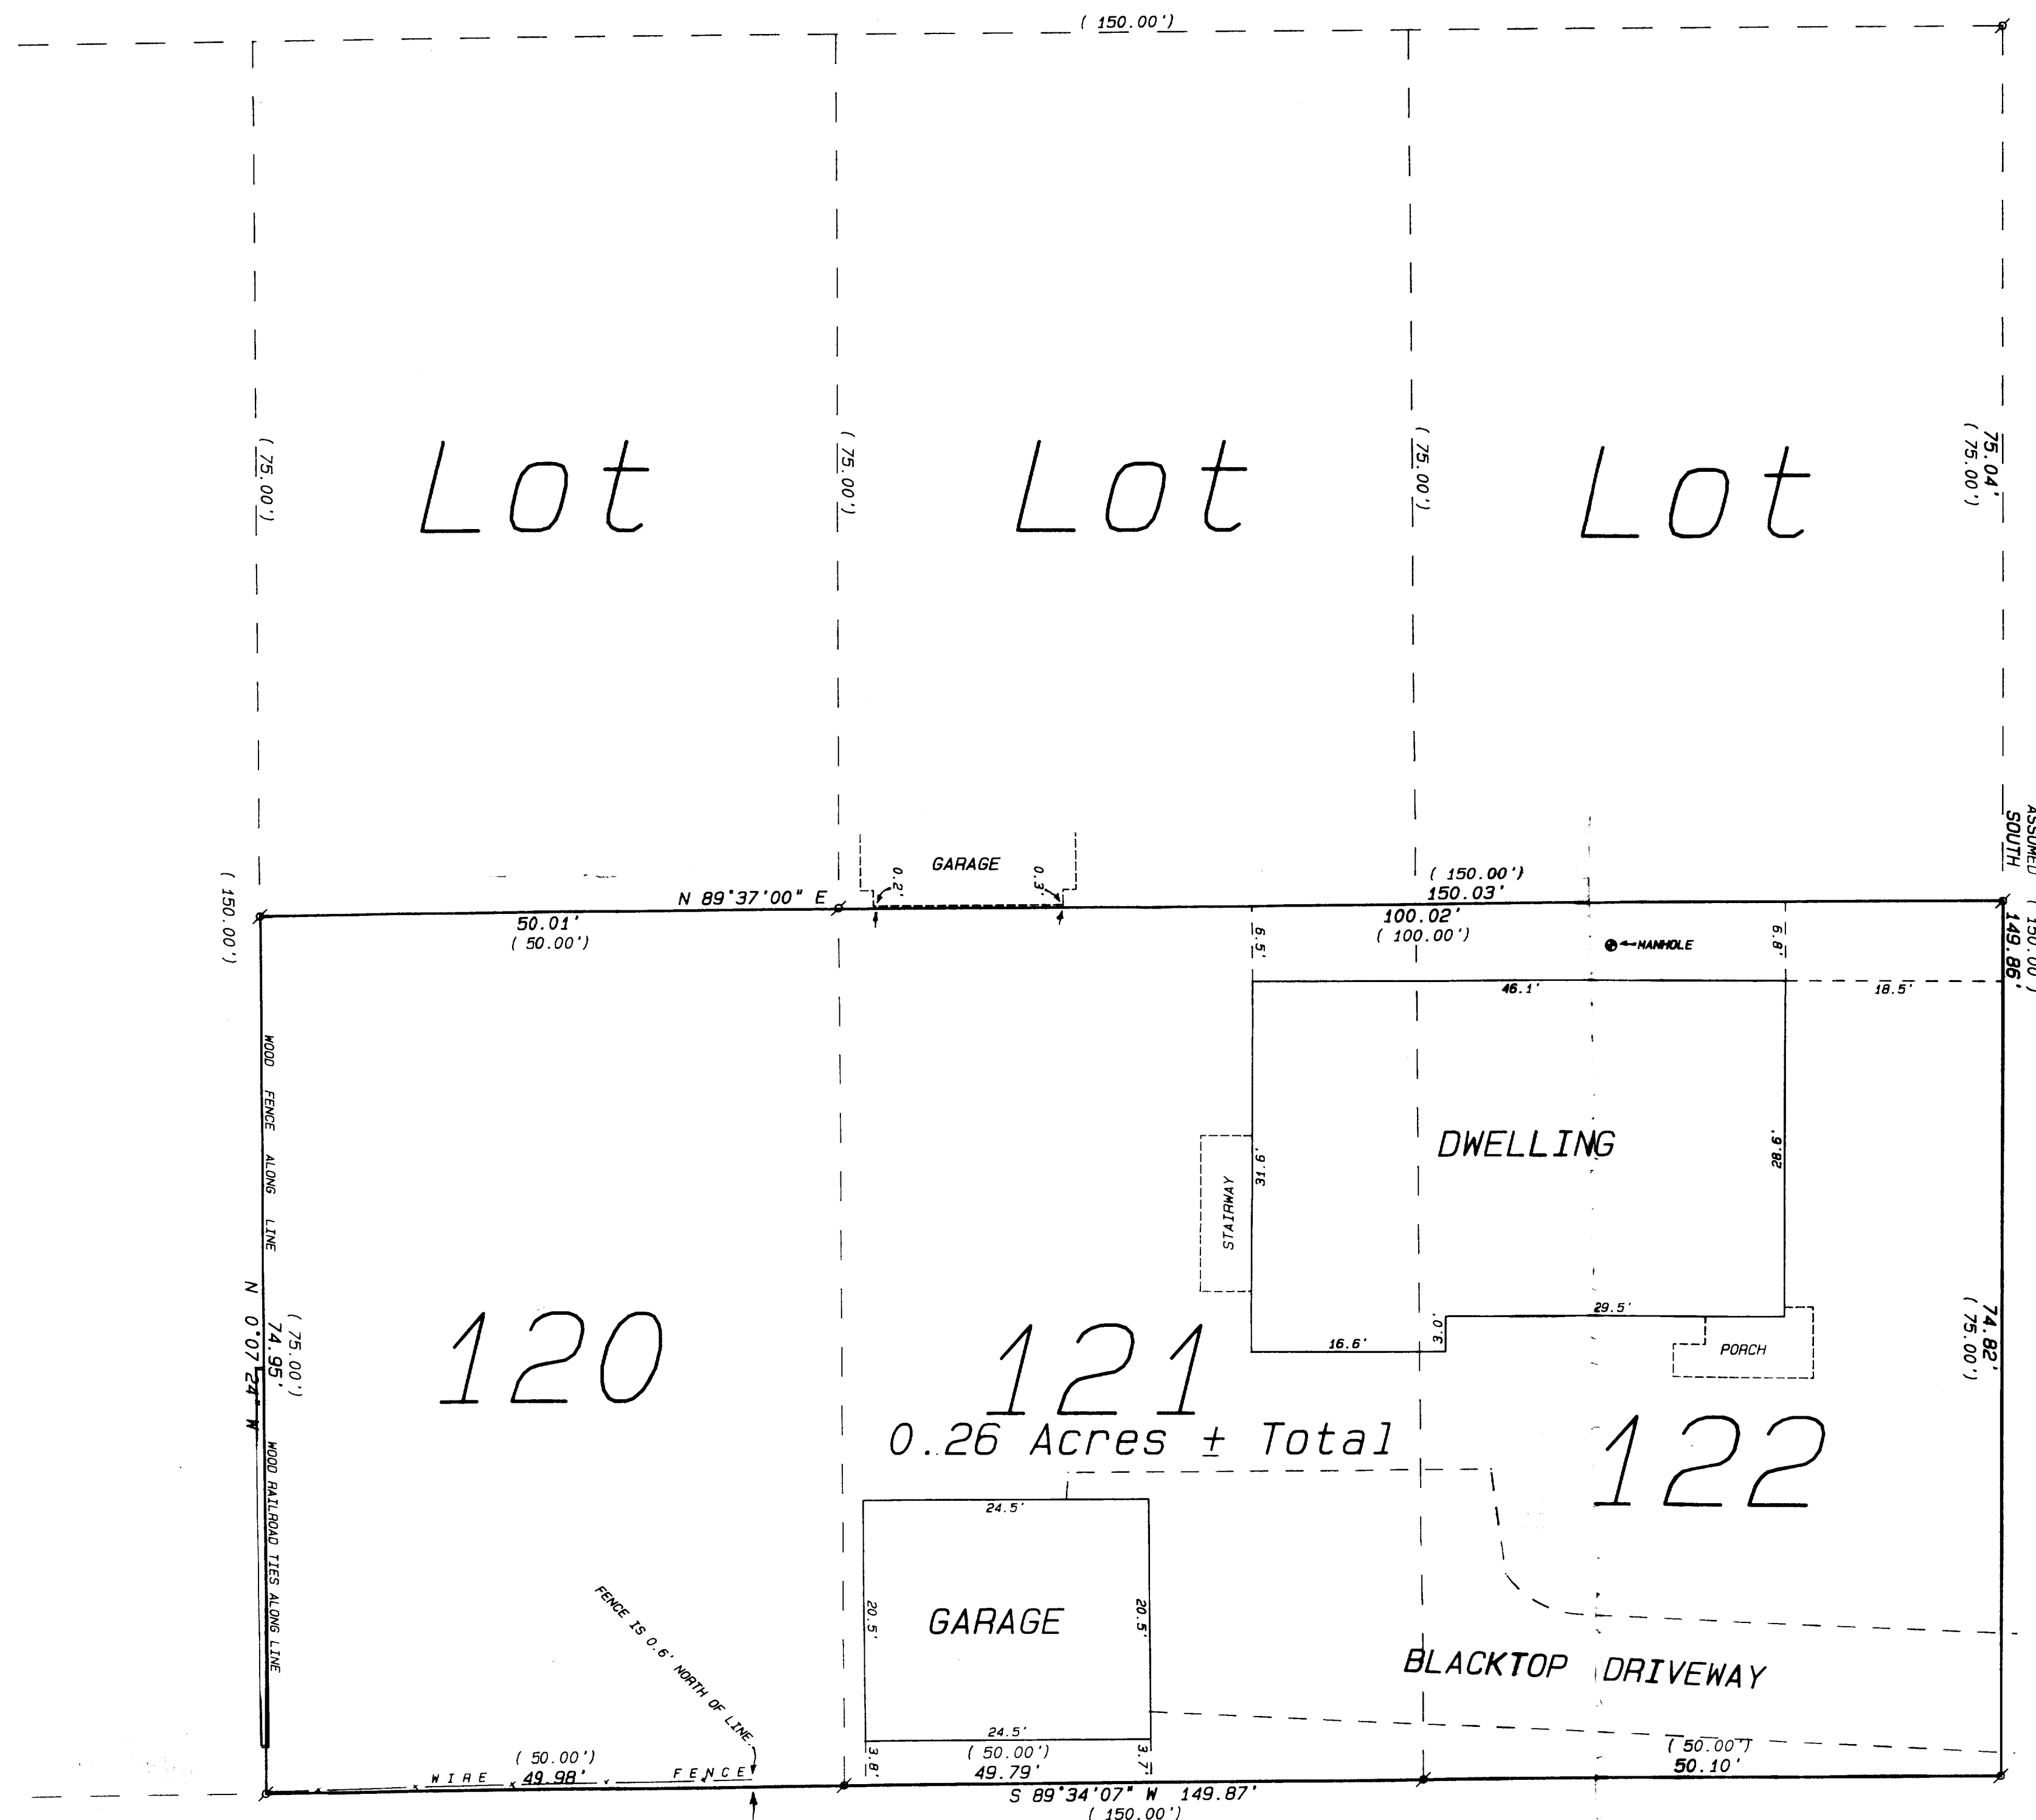


76' Wide

Maxwell Street

Legend

- ✱ FOUND IRON PIPE
 - ✱ FOUND IRON ROD
 - FOUND BRASS CAPPED MONUMENT
 - FOUND CONCRETE MONUMENT
 - ✱ CHISEL CUT IN CONCRETE
 - SET IRON ROD, 24" LONG, WEIGHING 1.5 LBS./LINEAL FT., 3/4" DIA.
 - SET IRON ROD, 30" LONG, WEIGHING 4.5 LBS./LINEAL FT., 1-11/16" DIA.
- (XX) RECORDED AS DIMENSION
- X— EXISTING FENCE

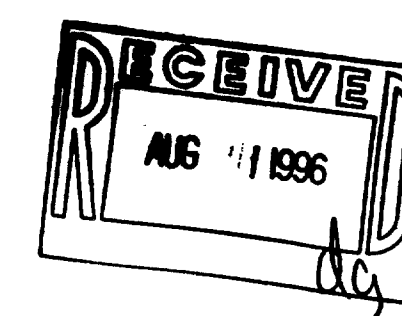

SCALE: 1" = 10 FEET



I hereby certify that the above described property has been surveyed by me or under my direction and that the above map is a true representation thereof and shows the size and location of the property, its exterior boundaries, the location of all visible structures and dimensions of all principal buildings thereon, boundary fences, apparent easements, roadways and visible encroachments, if any.

This survey is made for the use of the present owners of the property and also those who purchase, mortgage, or guarantee the title thereto within one year from date hereof.

KENNETH B. ABERNATHY, JR.
WISCONSIN REGISTERED LAND SURVEYOR

Date: July 23, 1996 Job No. 1996.70

Owner: Florence C. Clarke
566 Maxwell Street
Lake Geneva, Wisconsin 53147

Ordered by: William R. Anderson
224 Mill Street
Lake Geneva, Wisconsin 53147

ZCL-91

007-1648