

ABERNATHY and ASSOCIATES

Kenneth B. Abernathy Jr.

Wisconsin Registered Land Surveyor S-1594



Rt. 3, Box 273  
Elkhorn, Wisconsin 53121  
Phone: (414) 723-4260 (office)  
(414) 723-7209 (FAX)

# PLAT OF SURVEY

LOT 36 AND THE SOUTH 2 FEET OF LOT 37 OF  
STURWOOD ADDITION, LOCATED IN THE  
NORTHEAST 1/4 OF SECTION 35, TOWN 2  
NORTH, RANGE 17 EAST, CITY OF LAKE  
GENEVA, WALWORTH COUNTY, WISCONSIN.


ORDERED BY: ATTY ROBERT LEIBSLE  
GODFREY, NESHEK, WORTH & LEIBSLE, S.C.  
11 NORTH WISCONSIN STREET  
P.O. BOX 260  
ELKHORN, WI. 53121

OWNER: DENNIS R. ALLEN

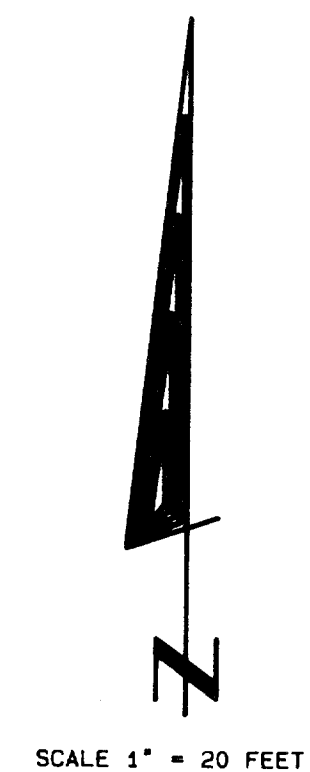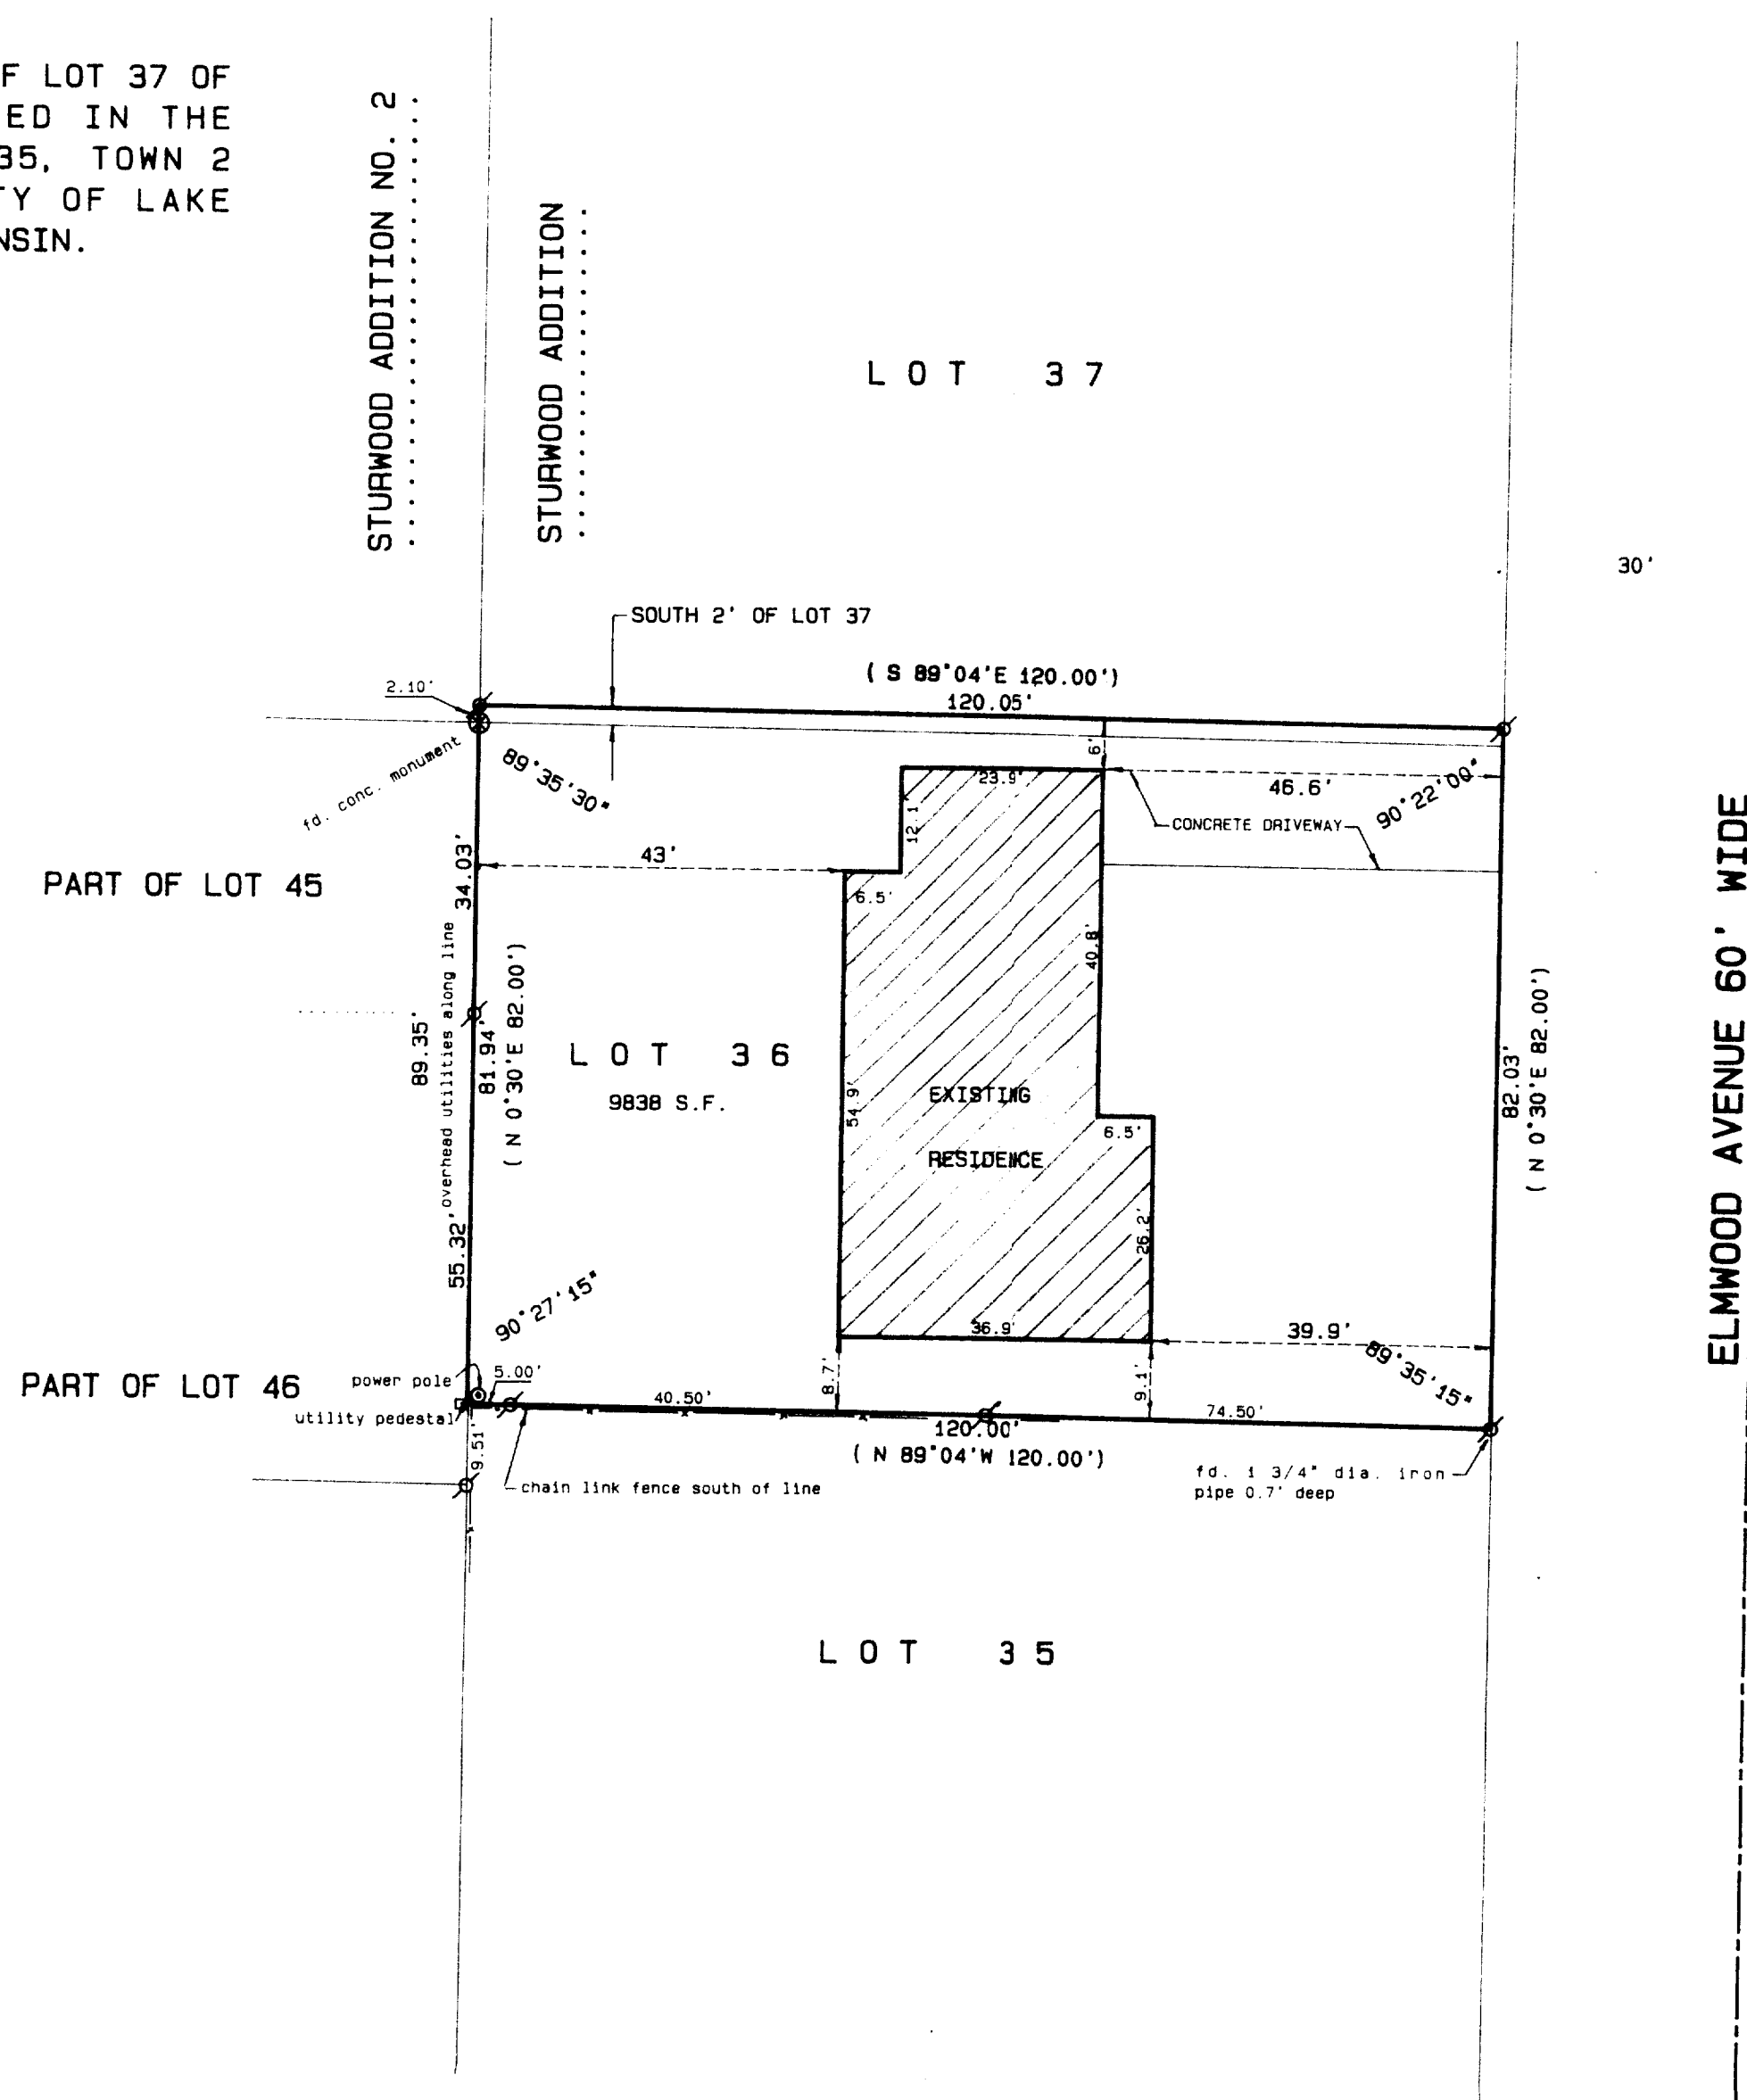


## Legend

- FOUND IRON PIPE
- FOUND IRON ROD
- FOUND BRASS CAPPED MONUMENT
- FOUND CONCRETE MONUMENT
- CHISEL CUT IN CONCRETE
- SET IRON ROD, 24" LONG, WEIGHING 1.5 LBS., LINEAL FT., 3/4" DIA.
- SET IRON ROD, 30" LONG, WEIGHING 4.5 LBS., LINEAL FT., 1-11/16" DIA.
- (xx) RECORDED AS DIMENSION
- EXISTING FENCE

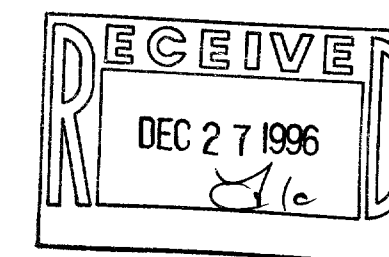

SCALE: 1" = 20 FEET

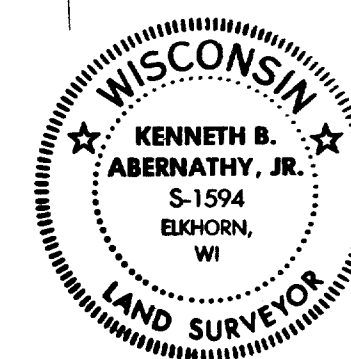

"I hereby certify that the above described property has been surveyed by me or under my direction and that the above map is a true representation thereof and shows the site and location of the property, its exterior boundaries, the location of all visible structures and dimensions of all principal buildings thereon, boundary fences, apparent easements, roadways and visible encroachments, if any."

"This survey is made for the use of the present owners of the property, and also those who purchase, mortgage, or guarantee the title thereto within one year from date hereof."

*Kenneth B. Abernathy, Jr.*

KENNETH B. ABERNATHY, JR.  
WISCONSIN REGISTERED LAND SURVEYOR,  
S-1594  
Date: SEPT. 11, 1996 Job No. 96.903

ZST-35

007-1666