


HAROLD H. KOLB
REGISTERED PROFESSIONAL LAND SURVEYOR
LAKE GENEVA, WISCONSIN

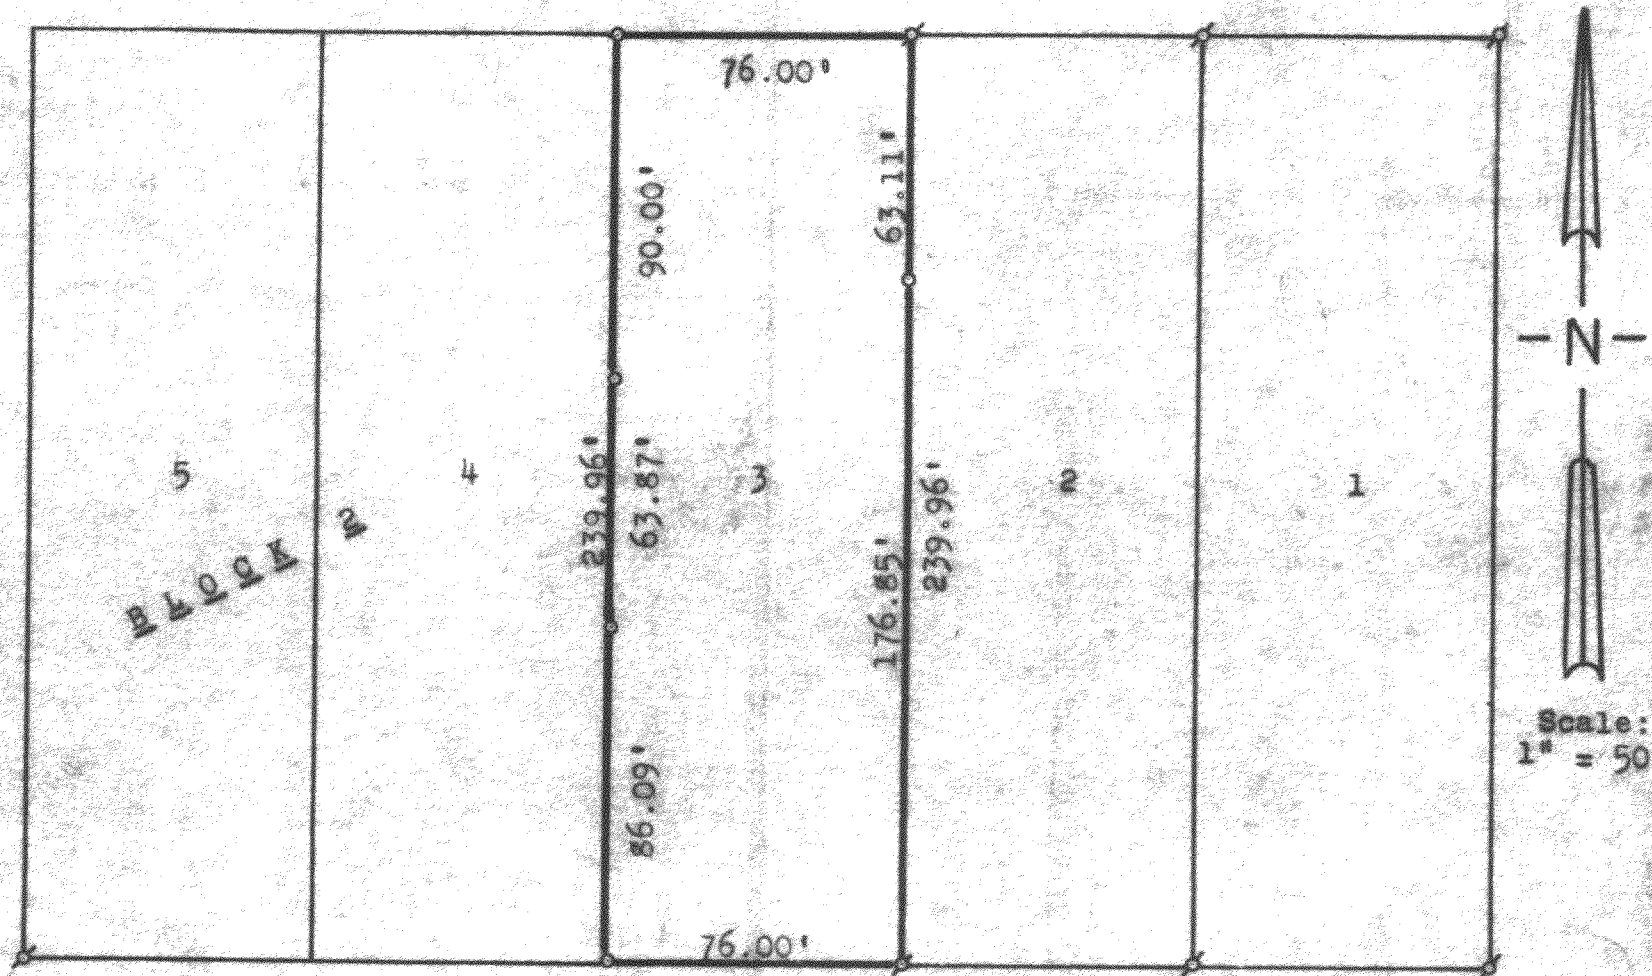

PLAT OF SURVEY OF

Lot 3, Block 2, E.D. Phillips Subdivision, City of Lake
Geneva, Walworth County, Wisconsin.

- Found iron pipe
- Set iron pipe

ZPI-VI

Harold H. Kolb
Harold H. Kolb, Wisconsin Surveyor, S-187
DATE: April 30, 1964.

7-168