


WISCONSIN ST.

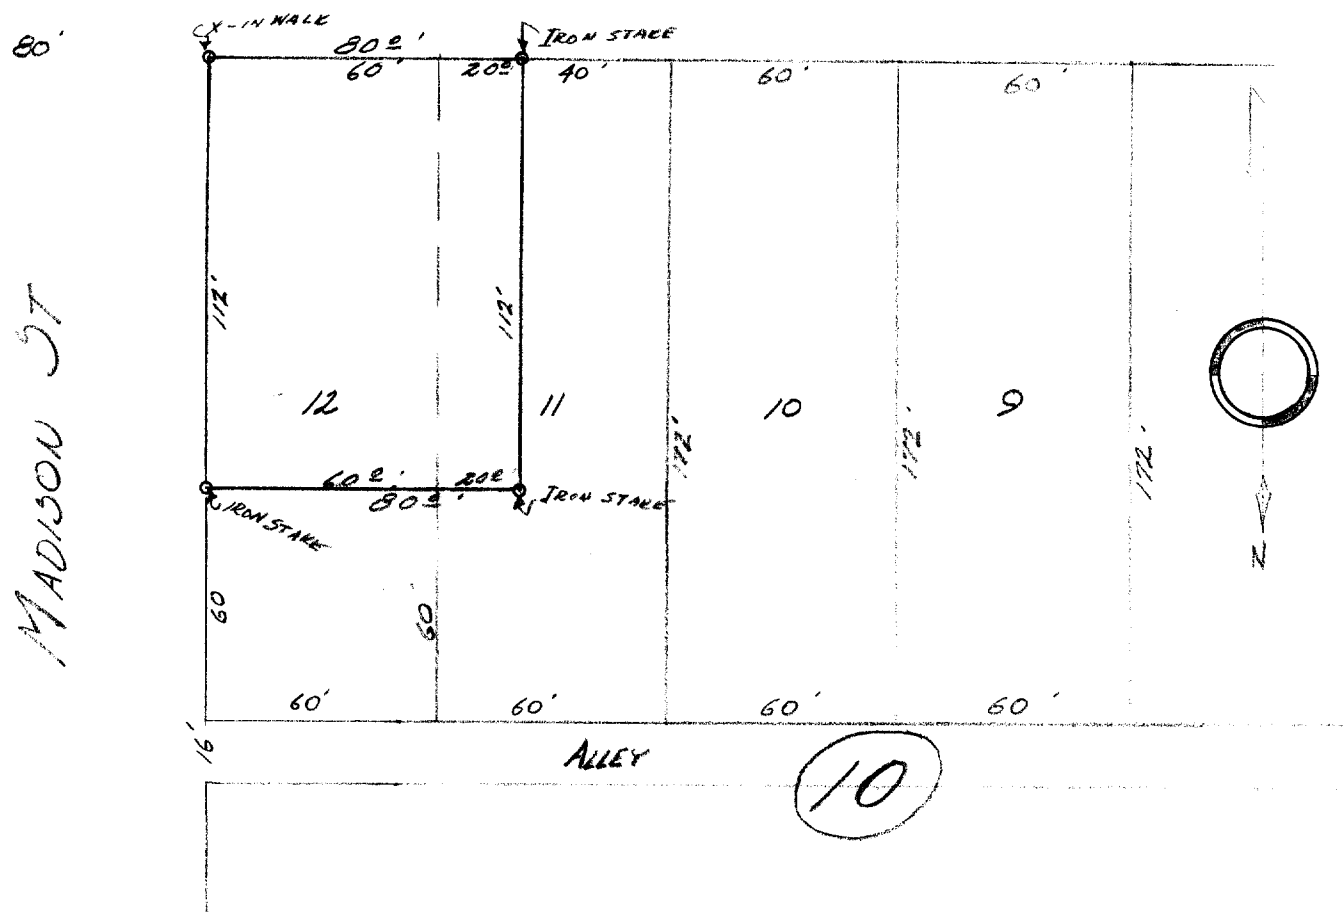

DESCRIPTION:::

The South 112.0 feet of Lot 12, Block 10 and the South 112.0 feet of the East 20.0 feet of Lot 11, Block 10, all of the Original Plat of the City of Lake Geneva, Walworth County, Wisconsin.

CERTIFICATE:

I, hereby certify that I have on this the 24th day of February 1955, surveyed the above described and portrayed property, according to the official records on file in the office of the Recorder of Deeds in and for Walworth County, Wisconsin, and find that no encroachments exist.

SIGNED AND SEALED ON THIS THE 24TH DAY OF FEBRUARY 1955.

Joseph M. Biagi. Professional Engineer
Elkhorn Wisconsin.