

ABERNATHY and ASSOCIATES

Kenneth B. Abernathy Jr.

Wisconsin Registered Land Surveyor S-1594

Rt. 3, Box 273
Elkhorn, Wisconsin 53121
Phone: (414) 723-4260 (office)
(414) 723-7209 (FAX)


PLAT OF SURVEY

LOTS 16 THRU 18 AND A
PORTION OF A VACATED ALLEY
OF BLOCK 3 OF LAKE GENEVA
HILLS SUBDIVISION LOCATED IN
THE SOUTHEAST 1/4 OF SECTION
26, TOWN 2 NORTH, RANGE 17
EAST, CITY OF LAKE GENEVA,
WALWORTH COUNTY, WISCONSIN.


TOTAL AREA = 18,547 S.F.

OWNER: JOE SCARO
126 IDA HALL LANE
ELKHORN, WI. 53121

50' WIDE (unimproved)
PLATT AVE.

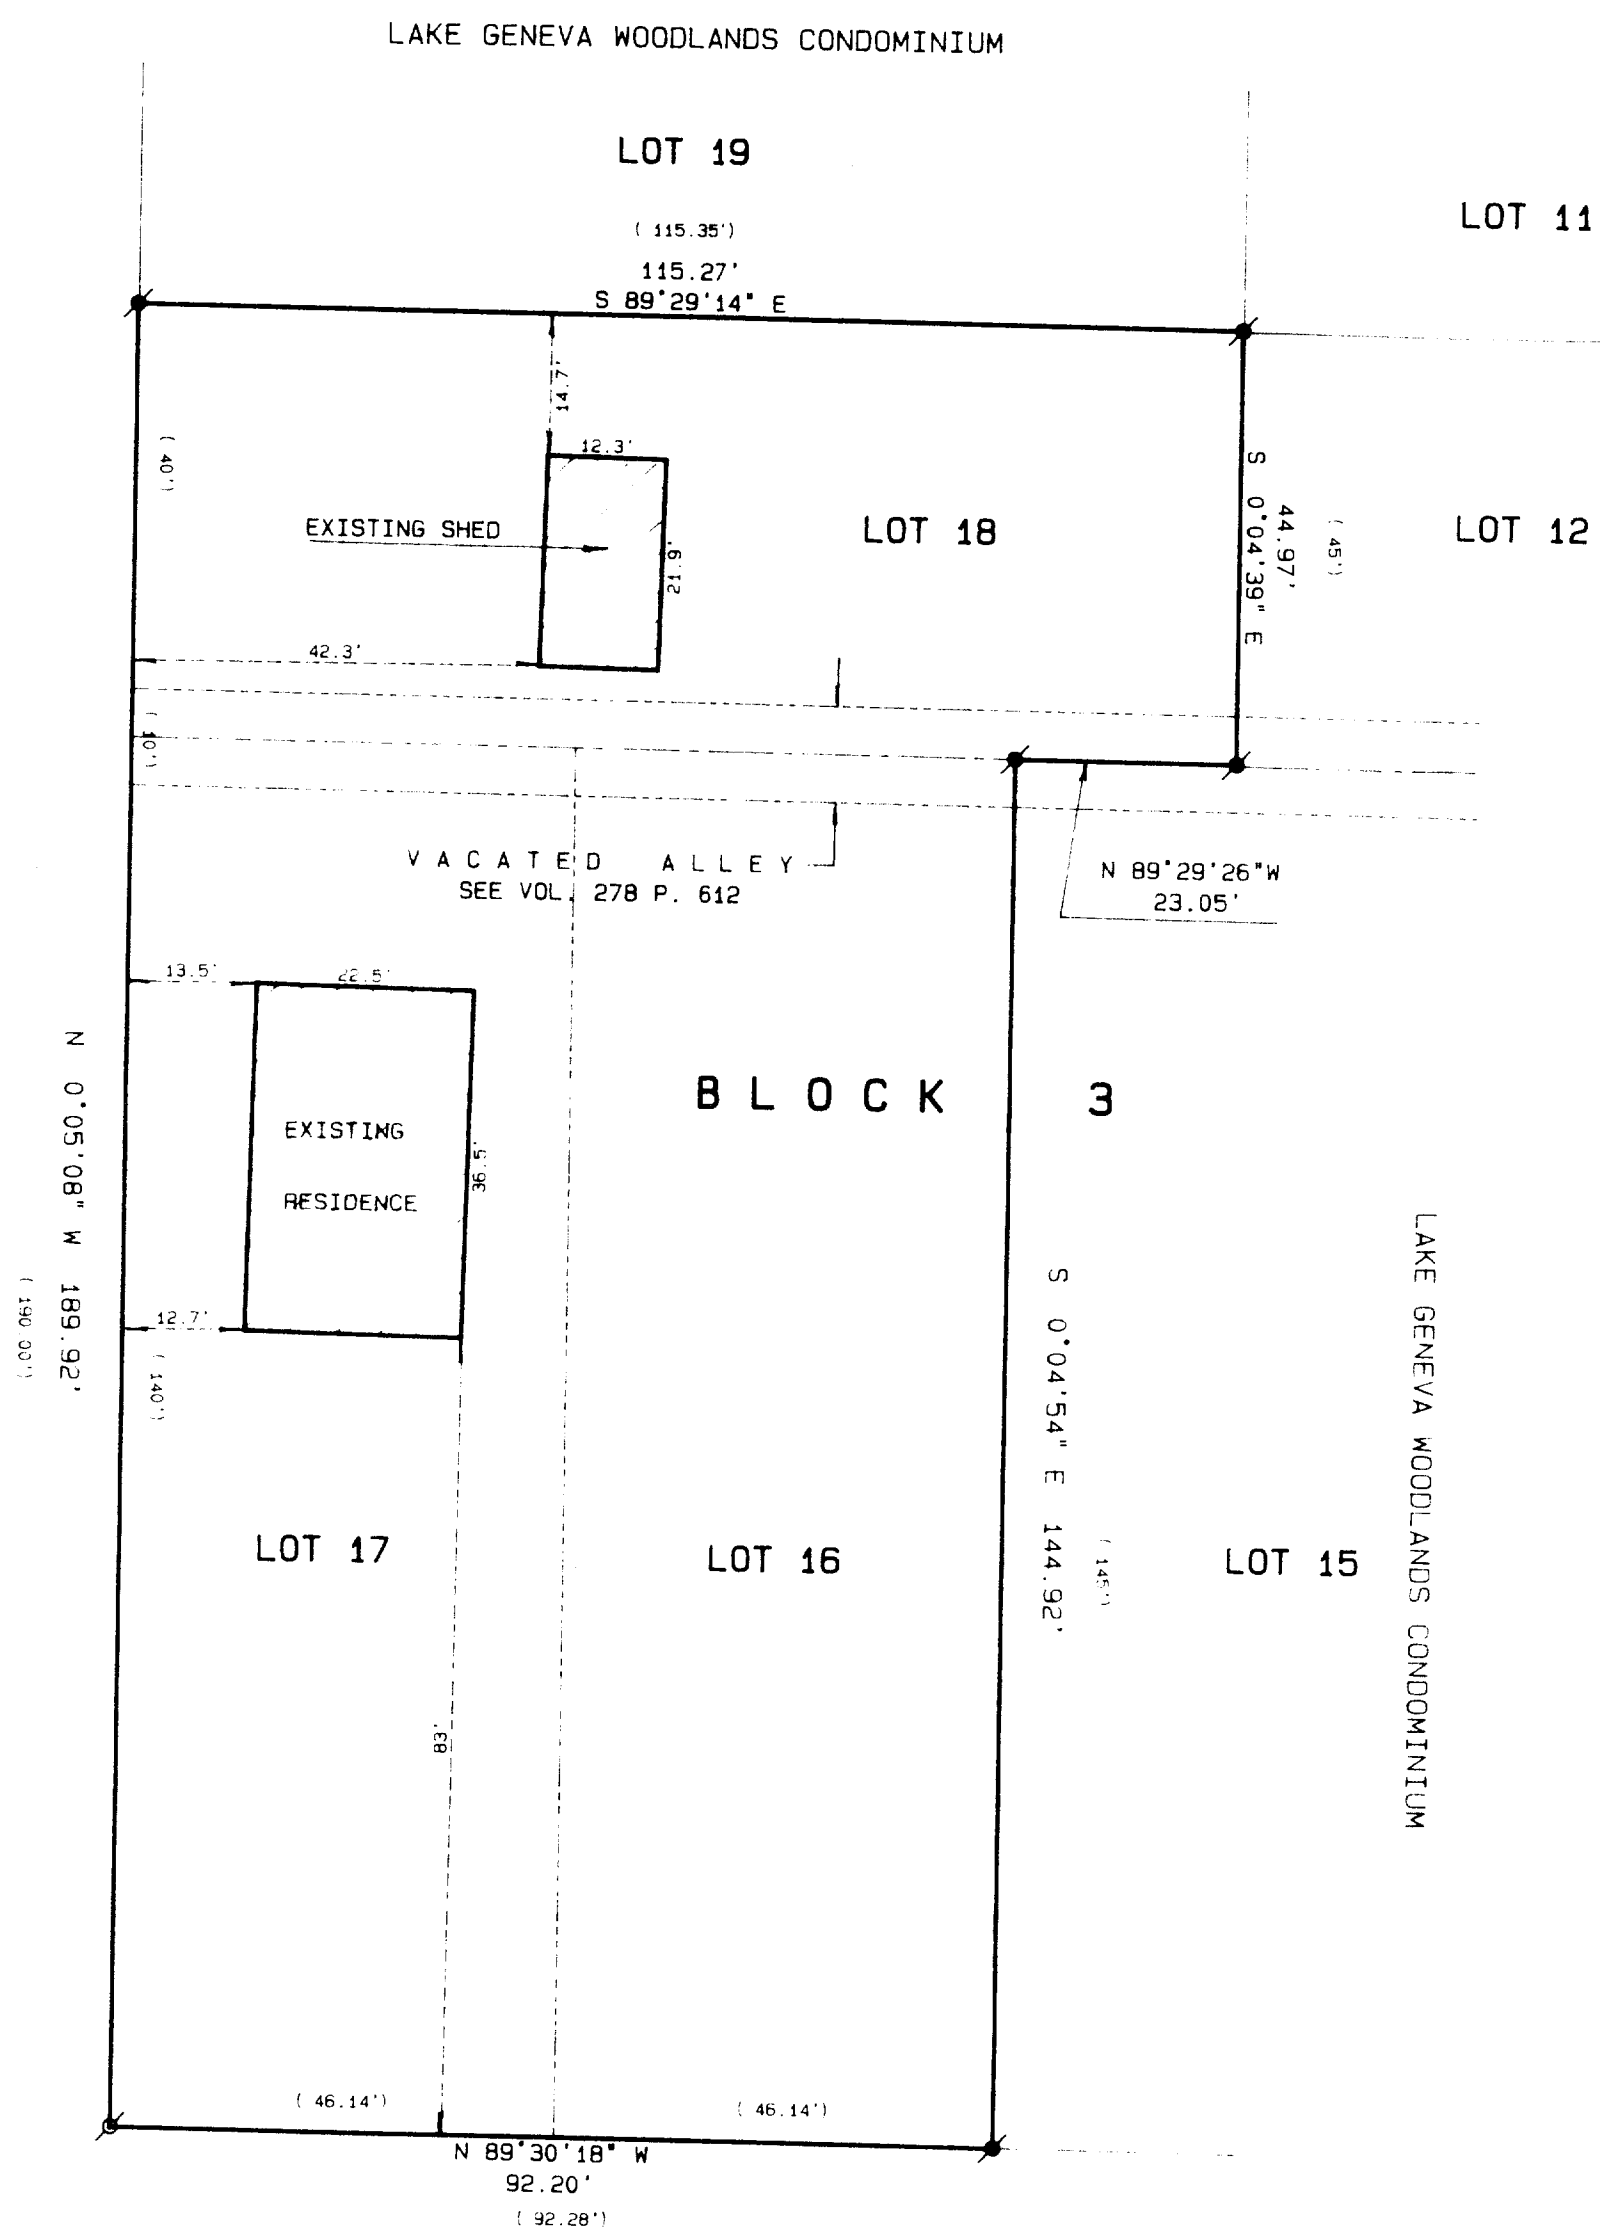


CONANT ST.
60 FEET WIDE PUBLIC ROAD

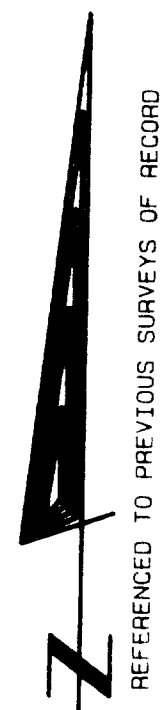

SCALE 1" = 20 FEET

Legend

- FOUND IRON PIPE
- FOUND IRON ROD
- FOUND BRASS CAPPED MONUMENT
- * FOUND CONCRETE MONUMENT
- + CHISEL CUT IN CONCRETE
- SET IRON ROD, 24" LONG, WEIGHING 1.5 LBS. LINEAL FT. 3/4" DIA.
- SET IRON ROD, 30" LONG, WEIGHING 4.5 LBS. LINEAL FT. 1 1/16" DIA.
- RECORDED AS DIMENSION
- EXISTING FENCE

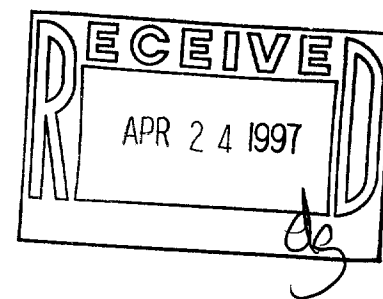

SCALE: 1" = 20 FEET



I hereby certify that the above described property has been surveyed by me in the direction and that the above map is a true and correct representation of the site and location of the property, its boundaries, the location of all visible structures and dimensions of all permanent buildings, the owner's improvements, easements, setbacks, and other encumbrances, if any.

This survey is made for the use of the present owners of the property and is not to be used for any other purpose or to guarantee the title thereto within the year of completion hereof.

KENNETH B. ABERNATHY, JR.
WISCONSIN REGISTERED LAND SURVEYOR,
S-1594

Date: APRIL 3, 1997 Job No. 97-402

244-12
007-1709