


FARRIS, HANSEN & ASSOCIATES, INC.

ENGINEERING, ARCHITECTURE, SURVEYING

7 RIDGEWAY COURT - P.O. BOX 437, ELKHORN, WISCONSIN, 53121



PHONE: (414) 723-2098 FAX: (414) 723-5886

LOT 6 OF GARRISON GLEN SUBDIVISION
LOCATED IN THE SW & SE 1/4'S OF THE NE 1/4 OF SECTION 1
TOWN 1 NORTH, RANGE 17 EAST, CITY OF LAKE GENEVA
WALWORTH COUNTY, WISCONSIN

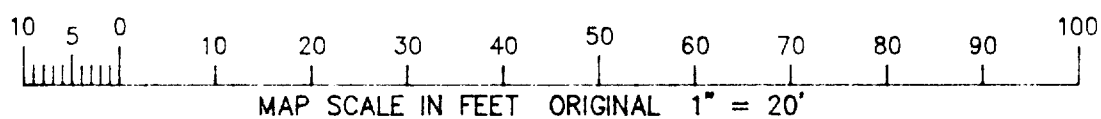

WORK ORDERED BY:
COUNTRY CREEK HOMES
1400 HICKS ROAD
ROLLING MEADOWS, IL 60008

○ = FOUND IRON PIPE STAKE
● = FOUND IRON REBAR STAKE
- = SET IRON REBAR STAKE
(XXX) = RECORDED AS

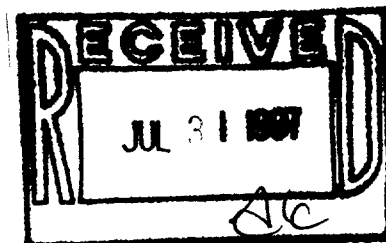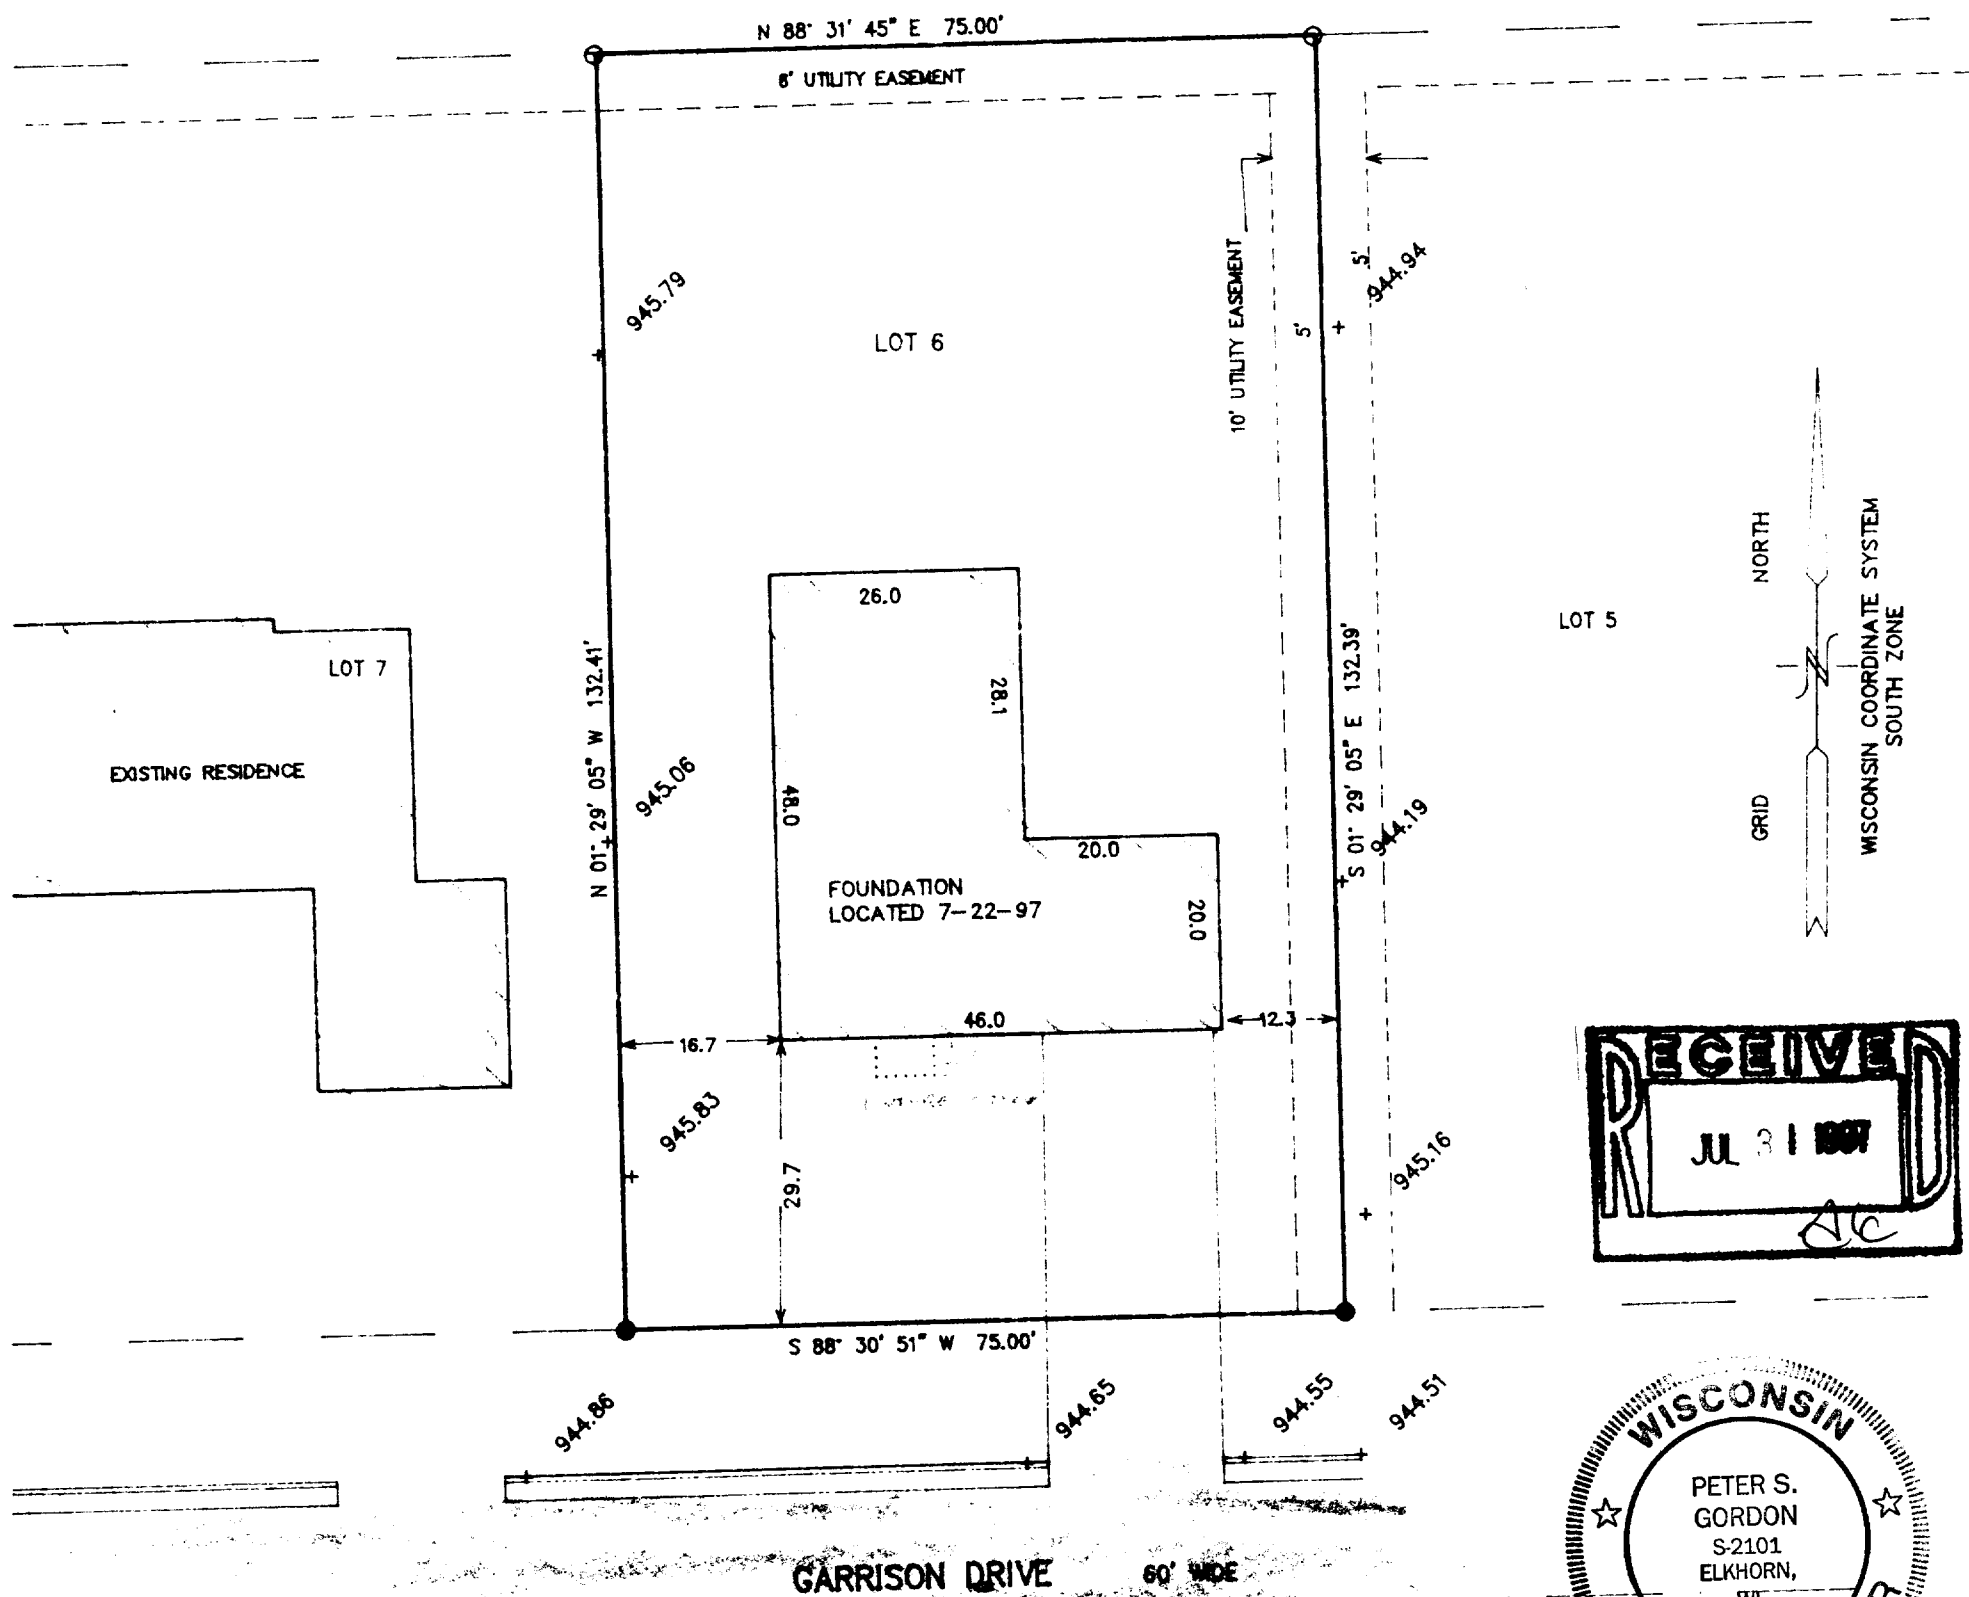

NOTE: COPIES OF THIS MAP TO WHICH THE FOLLOWING CERTIFICATE WILL APPLY ARE BLUE LINE PRINTS SHOWING SURVEYOR'S ORIGINAL SEAL AND SIGNATURE IN BLACK INK. COPIES BY ANY OTHER MEANS MAY HAVE ALTERATIONS WHICH DO NOT REPRESENT THE SURVEYOR'S WORK PRODUCT.

I HEREBY CERTIFY THAT THE ABOVE DESCRIBED PROPERTY HAS BEEN SURVEYED UNDER MY DIRECTION AND THAT THE ABOVE MAP IS A TRUE REPRESENTATION THEREOF AND SHOWS THE SIZE AND LOCATION OF THE PROPERTY AND ITS EXTERIOR BOUNDARIES. THIS SURVEY IS MADE FOR THE USE OF THE PRESENT OWNERS OF THE PROPERTY, AND ALSO THOSE WHO PURCHASE, MORTGAGE, OR GUARANTEE THE TITLE THERETO WITHIN ONE YEAR FROM THE DATE HEREOF.

DATED: 7-22-97

PETER S. GORDON R.L.S. 2101

PROJECT 3279.6

SHEET 1 OF 1

ZGAR-6 007-1729