

DEGEN, FOAT SURVEYING ASSOCIATES


100 SOUTH SECOND STREET
WATERFORD, WISCONSIN
(414)534-5404 (FAX)534-2022

982124
982124S1.DWG

PLAT OF SURVEY

LOTS 1, 2, 3 & 4 IN DUN ROMIN ACRES, A SUBDIVISION
LOCATED IN SECTION 6, TOWN 1 NORTH, RANGE 18 EAST,
OF THE FOURTH PRINCIPAL MERIDIAN, CITY OF LAKE GENEVA,
WALWORTH COUNTY, WISCONSIN.


SURVEYED FOR: CARL THOMPSON
4757 RIVERSIDE ROAD
WATERFORD, WI 53185

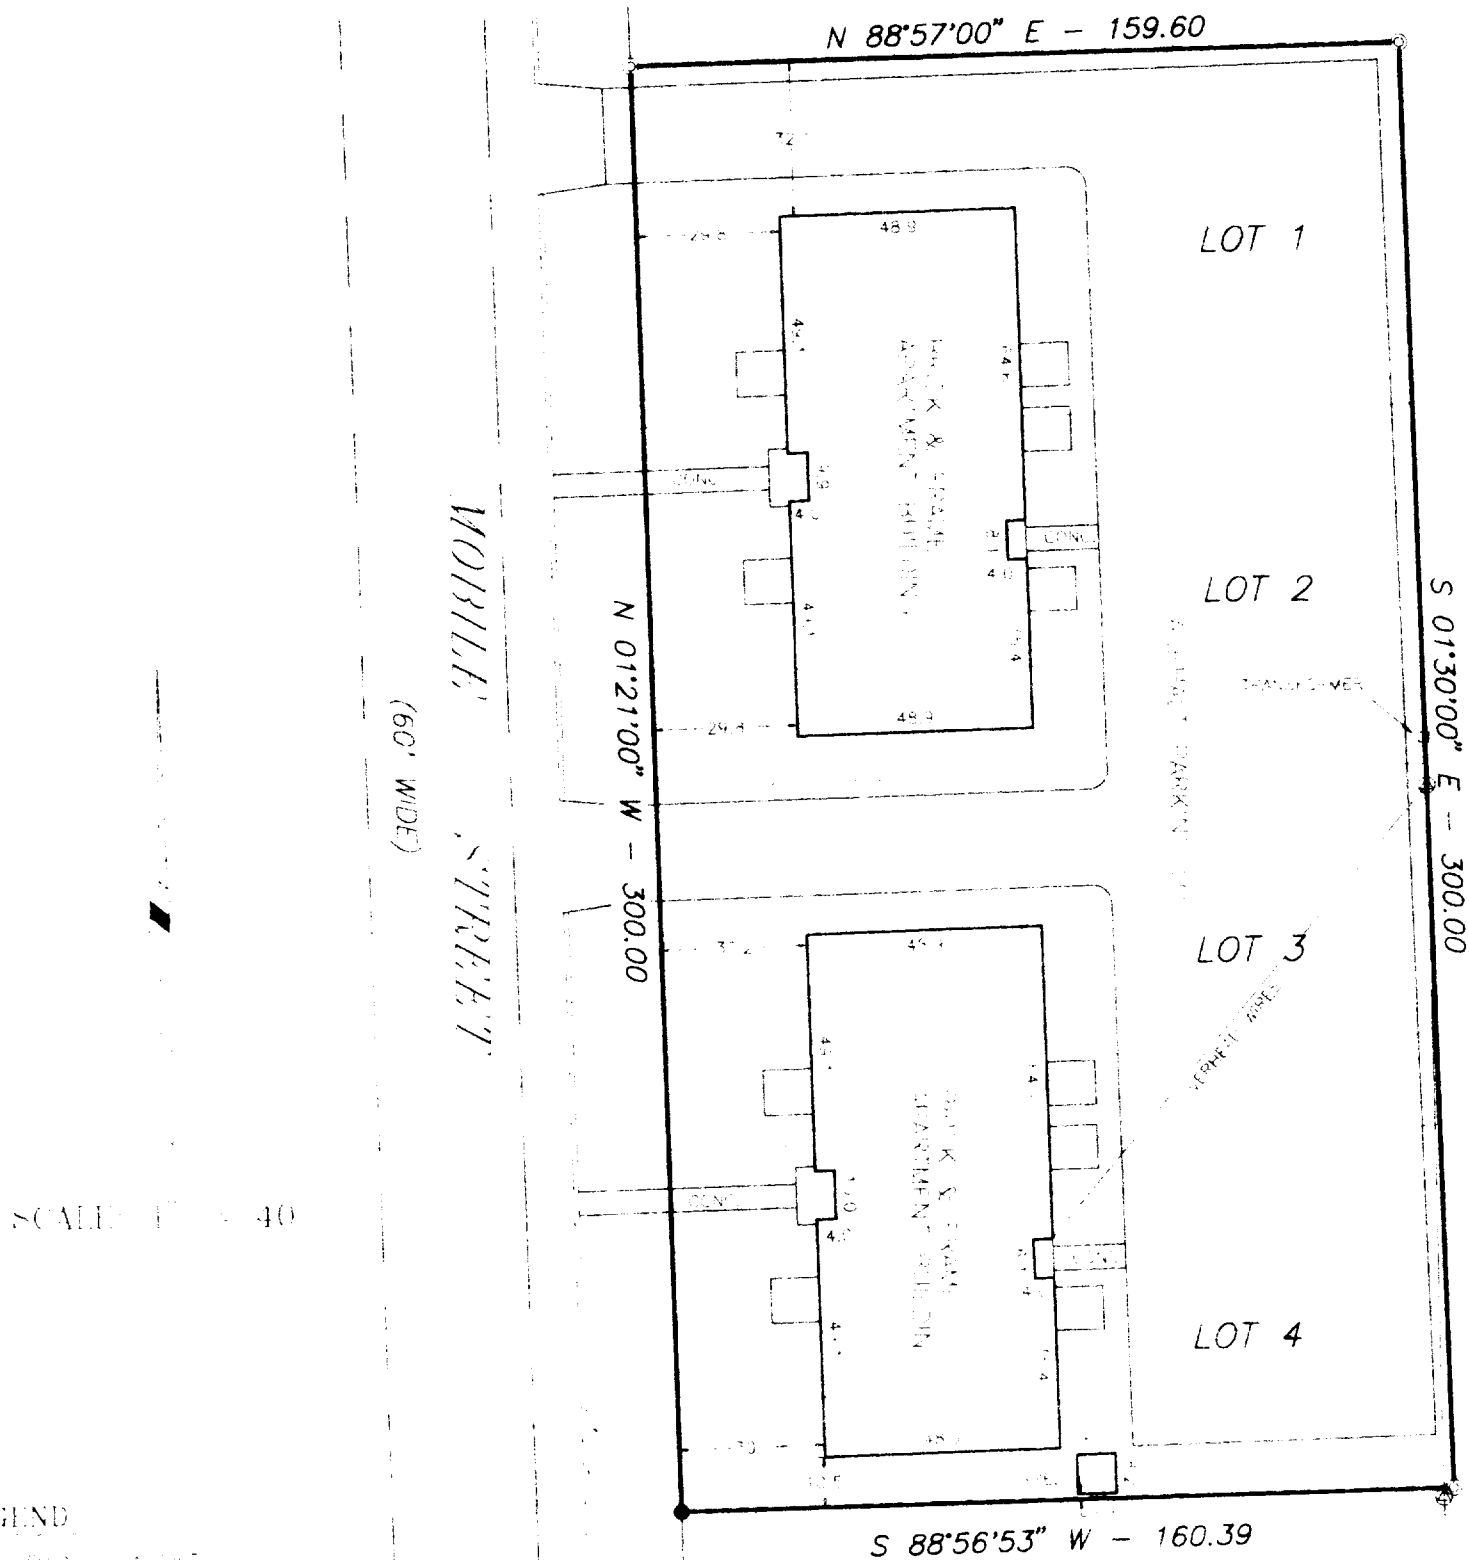

SCALE: 1" = 40'

LEGEND

- BOUNDARY LINE
- EASEMENT
- EASEMENT
- EASEMENT
- EASEMENT

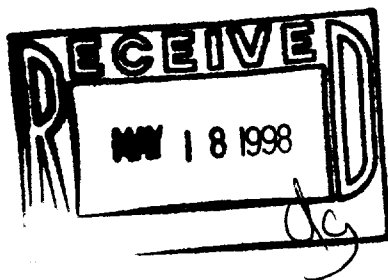

WHEREAS, DEGEN, FOAT SURVEYING ASSOCIATES, INC. HAS SURVEYED THE ABOVE DESCRIBED PROPERTY AND THE ABOVE MAP IS A TRUE REPRESENTATION THEREOF AND SHOWS THE SIZE AND LOCATION OF THE PROPERTY, THE LOCATION OF ALL VISIBLE STRUCTURES AND DIMENSIONS OF ALL PRINCIPAL BUILDINGS, HEREON, BOUNDARY LINES, APPARENT EASEMENTS, DRAINAGE DITCHES AND VISIBLE ENCROACHMENTS, IF ANY.

THIS SURVEY IS MADE FOR THE PRESENT OWNERS OF THE PROPERTY AND ALSO THOSE WHO PURCHASE OR GUARANTEE THE TITLE THEREOF WITHIN A YEAR FROM THE DATE HEREOF.

DATED AT WATERFORD, WISCONSIN, 10th DAY OF MARCH, 1998

DEGEN, FOAT SURVEYING ASSOCIATES, INC.

ZDA-1 007-1754