


NOTE: Encroachment of eaves
has been removed.
July 22, 1964

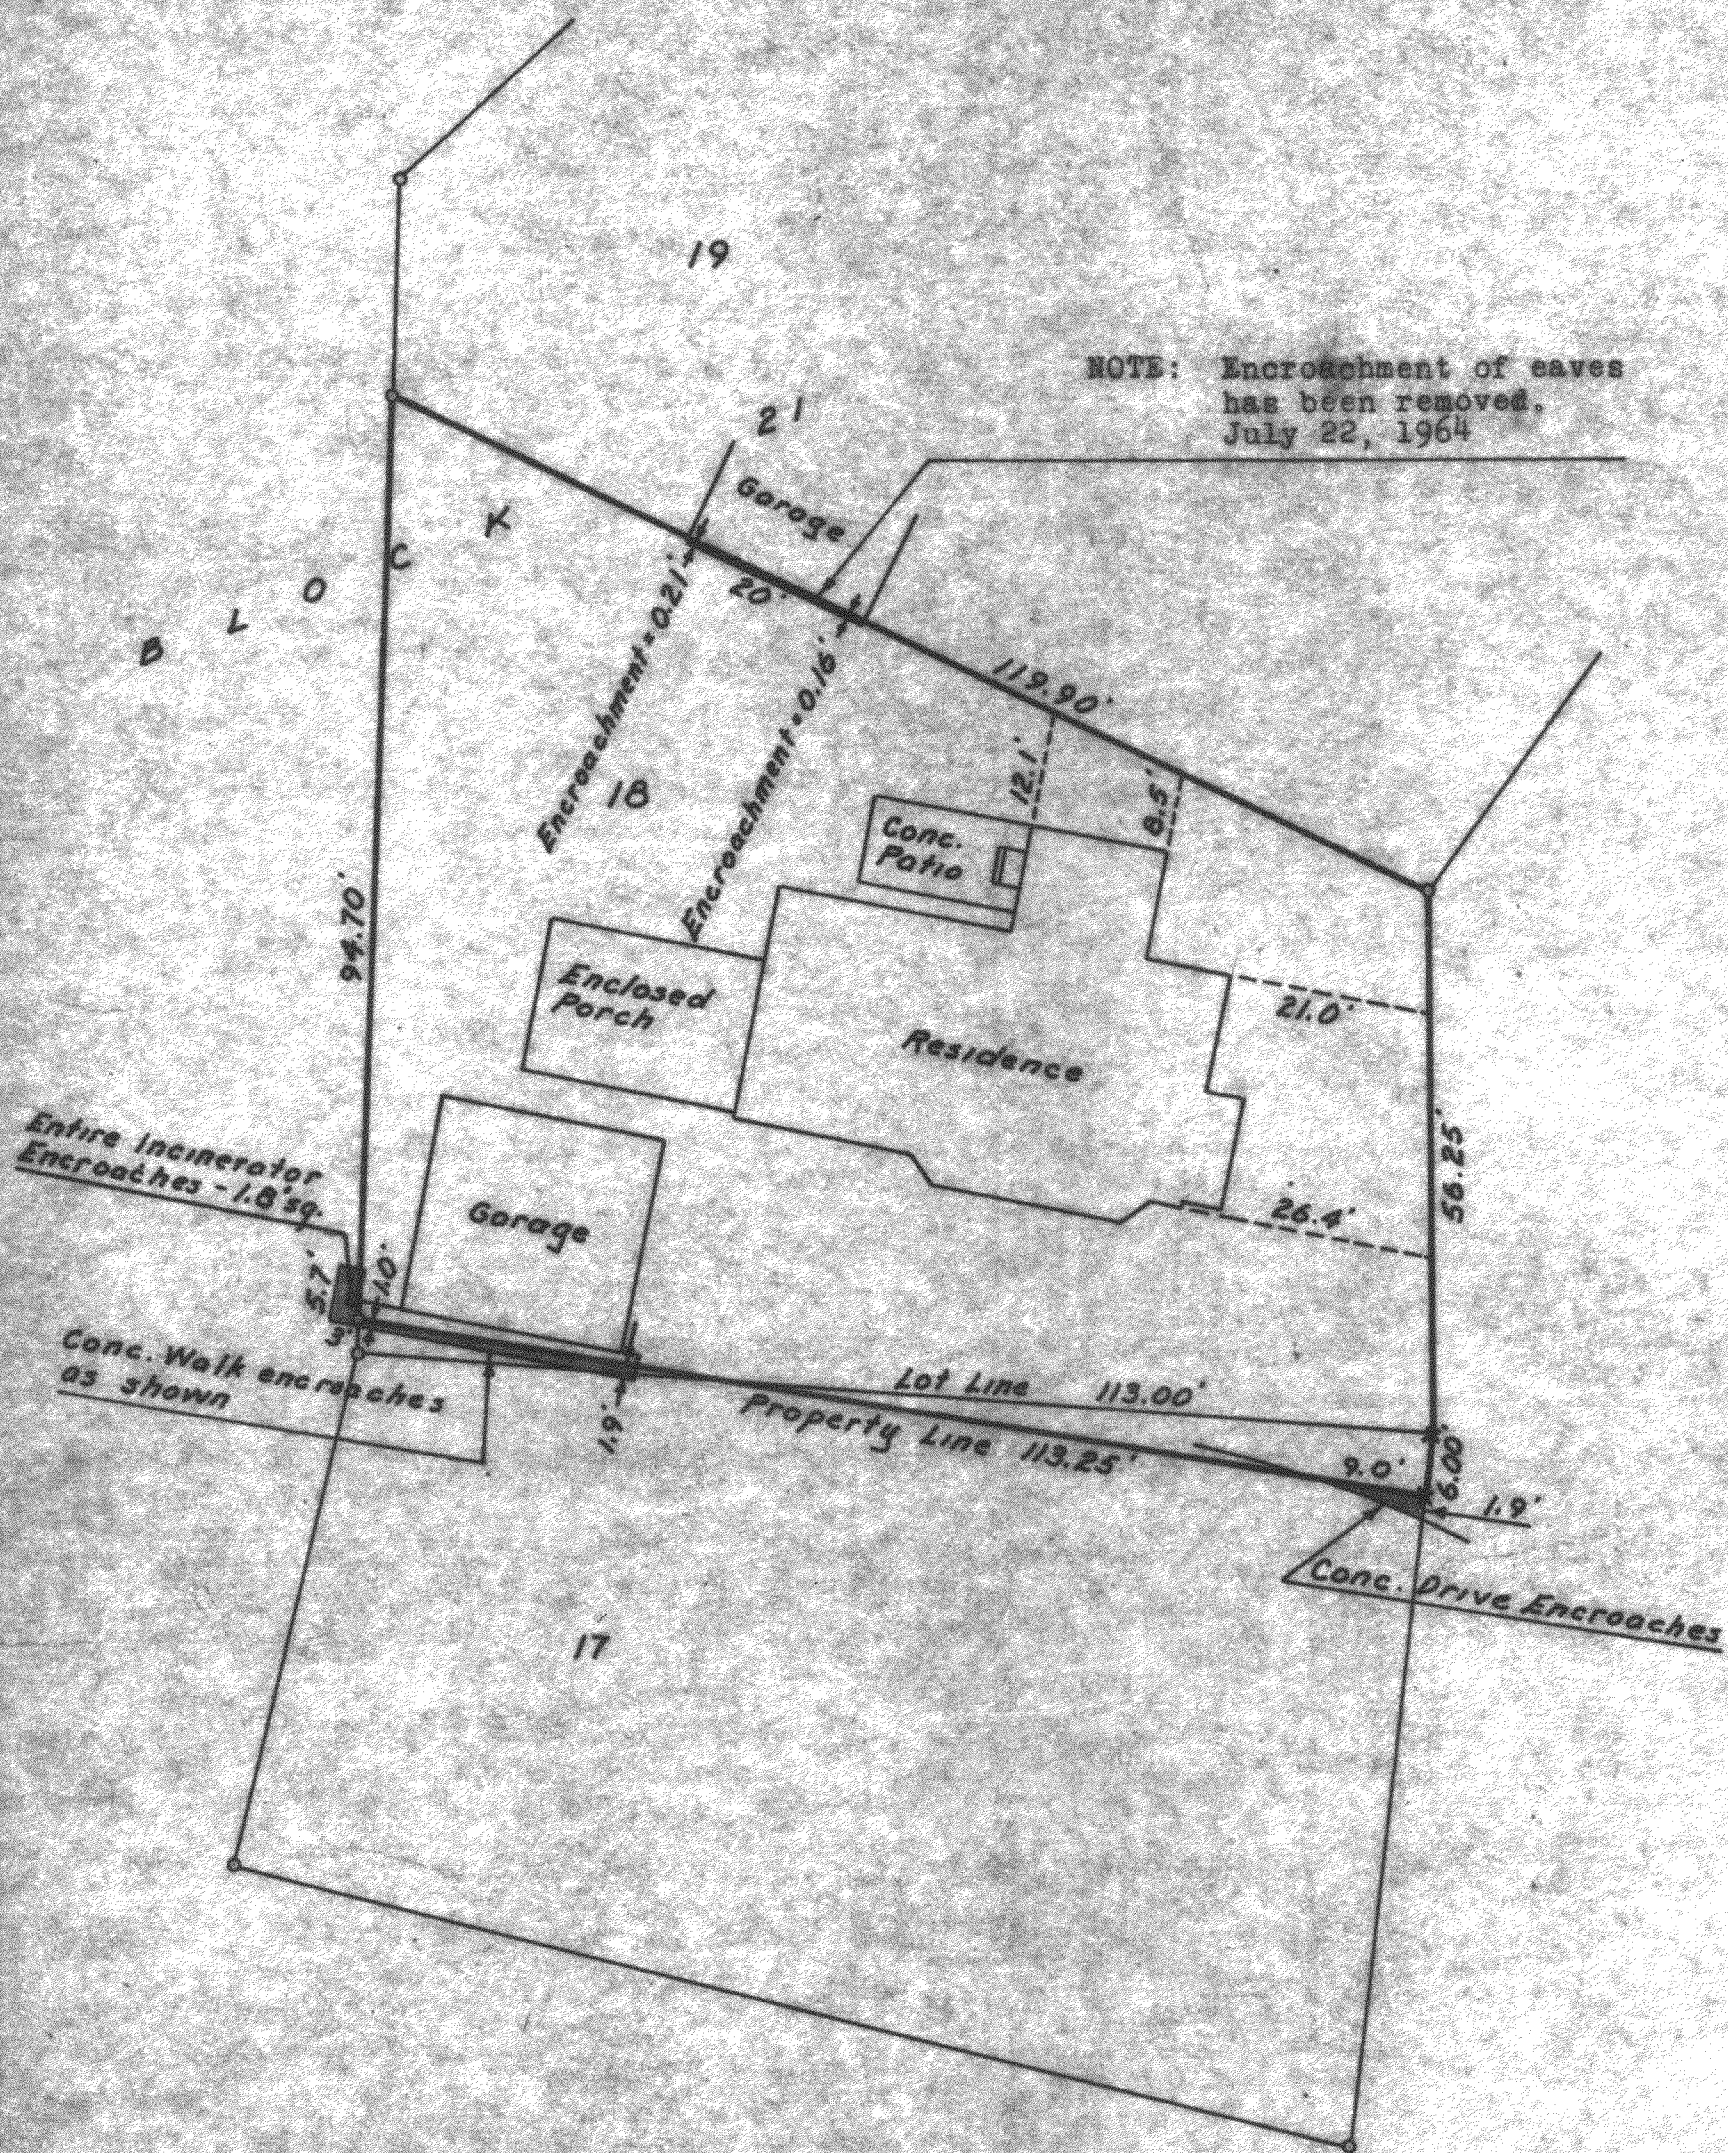

PLAT OF SURVEY OF

Lot 18 and part of Lot 17, Block 21, Lake Geneva Manor, a subdivision located in the East 1/2 of Section 35, T 2 N, R 17 E, City of Lake Geneva, Walworth County, Wisconsin.

Harold H. Kolb

Harold H. Kolb, Wisconsin Surveyor, S-187

DATE: July 14, 1964

REVISED: July 22, 1964