


PLAT OF SURVEY

ORDERED BY: BRADEN & OLSON
716 WISCONSIN ST.
LAKE GENEVA, WI. 53147


DATE: 1/19/1999

DESCRIPTION: THE NORTH FIFTY (50') FEET OF LOT (7) AND THE WEST TWENTY-THREE (23') FEET OF THE NORTH FIFTY (50') FEET OF LOT (8), ALL IN BLOCK SIXTEEN (16'), OF THE ORIGINAL PLAT OF THE VILLAGE (NOW CITY) OF LAKE GENEVA, WALWORTH COUNTY, WISCONSIN.

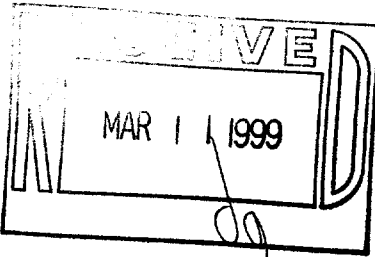



SCALE 1"=20'
BEARINGS REFERNCED TO
PREVIOUS SURVEY NUMBER
007-1750 RECORDED IN THE
WALWORTH COUNTY SURVEYORS
OFFICE.

C.L. BROAD STREET (100') WIDE

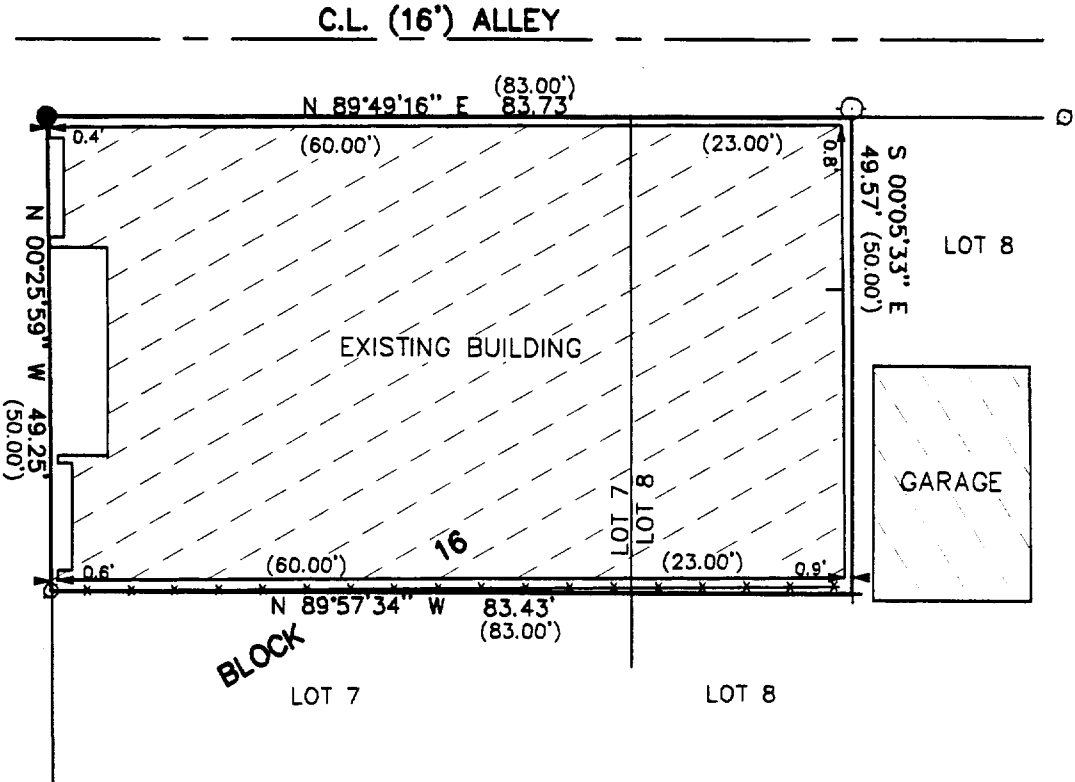

- LEGEND
- + PLACED CUT CROSS IN CONCRETE
 - SET RAILROAD SPIKE
 - FOUND IRON PIPE
 - ⊙ POWER POLE
 - FENCE
 - (XXXXX) RECORDED AS

PATHFINDER SURVEYING
FORMERLY KOLB LAND CONSULTING
929 WILLIAMS STREET LAKE GENEVA, WI. 53147
(414) 248-3697

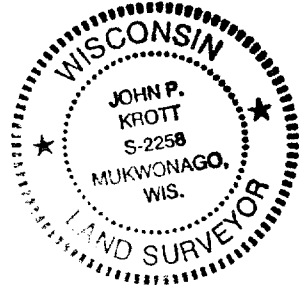

THE ABOVE MAP IS A TRUE REPRESENTATION THEREOF AND SHOWS THE SIZE AND LOCATION OF ALL THE PROPERTY, EXTERIOR BOUNDARIES, THE LOCATION OF ALL VISIBLE BOUNDARY FENCES, APPARENT EASEMENTS, ROADWAYS AND VISIBLE ENCROACHMENTS, IF ANY

THIS SURVEY IS MADE FOR THE USE OF THE PRESENT OWNERS OF THE PROPERTY, AND ALSO THOSE WHO PURCHASE, MORTGAGE OR GURANTEE TITLE THERETO WITHIN ONE (1) YEAR FROM DATE HERETO.

NOTE: THIS IS NOT A CERTIFIED COPY
UNLESS SEAL IS IN RED.
JOB NUMBER #99006 LG-ZOP-157A


JOHN P. KROTT, R.L.S. 2258

ZoP-157A

007-1811