


REGISTERED PROFESSIONAL LAND SURVEYOR
LAKE GENEVA, WISCONSIN

Property owned by Karl Keck, located in the East 1/2 of Section 35, T 2 N, R 17 E, City of Lake Geneva, Walworth County, Wisconsin, showing location of base line and distances to the high water mark of Geneva Lake.

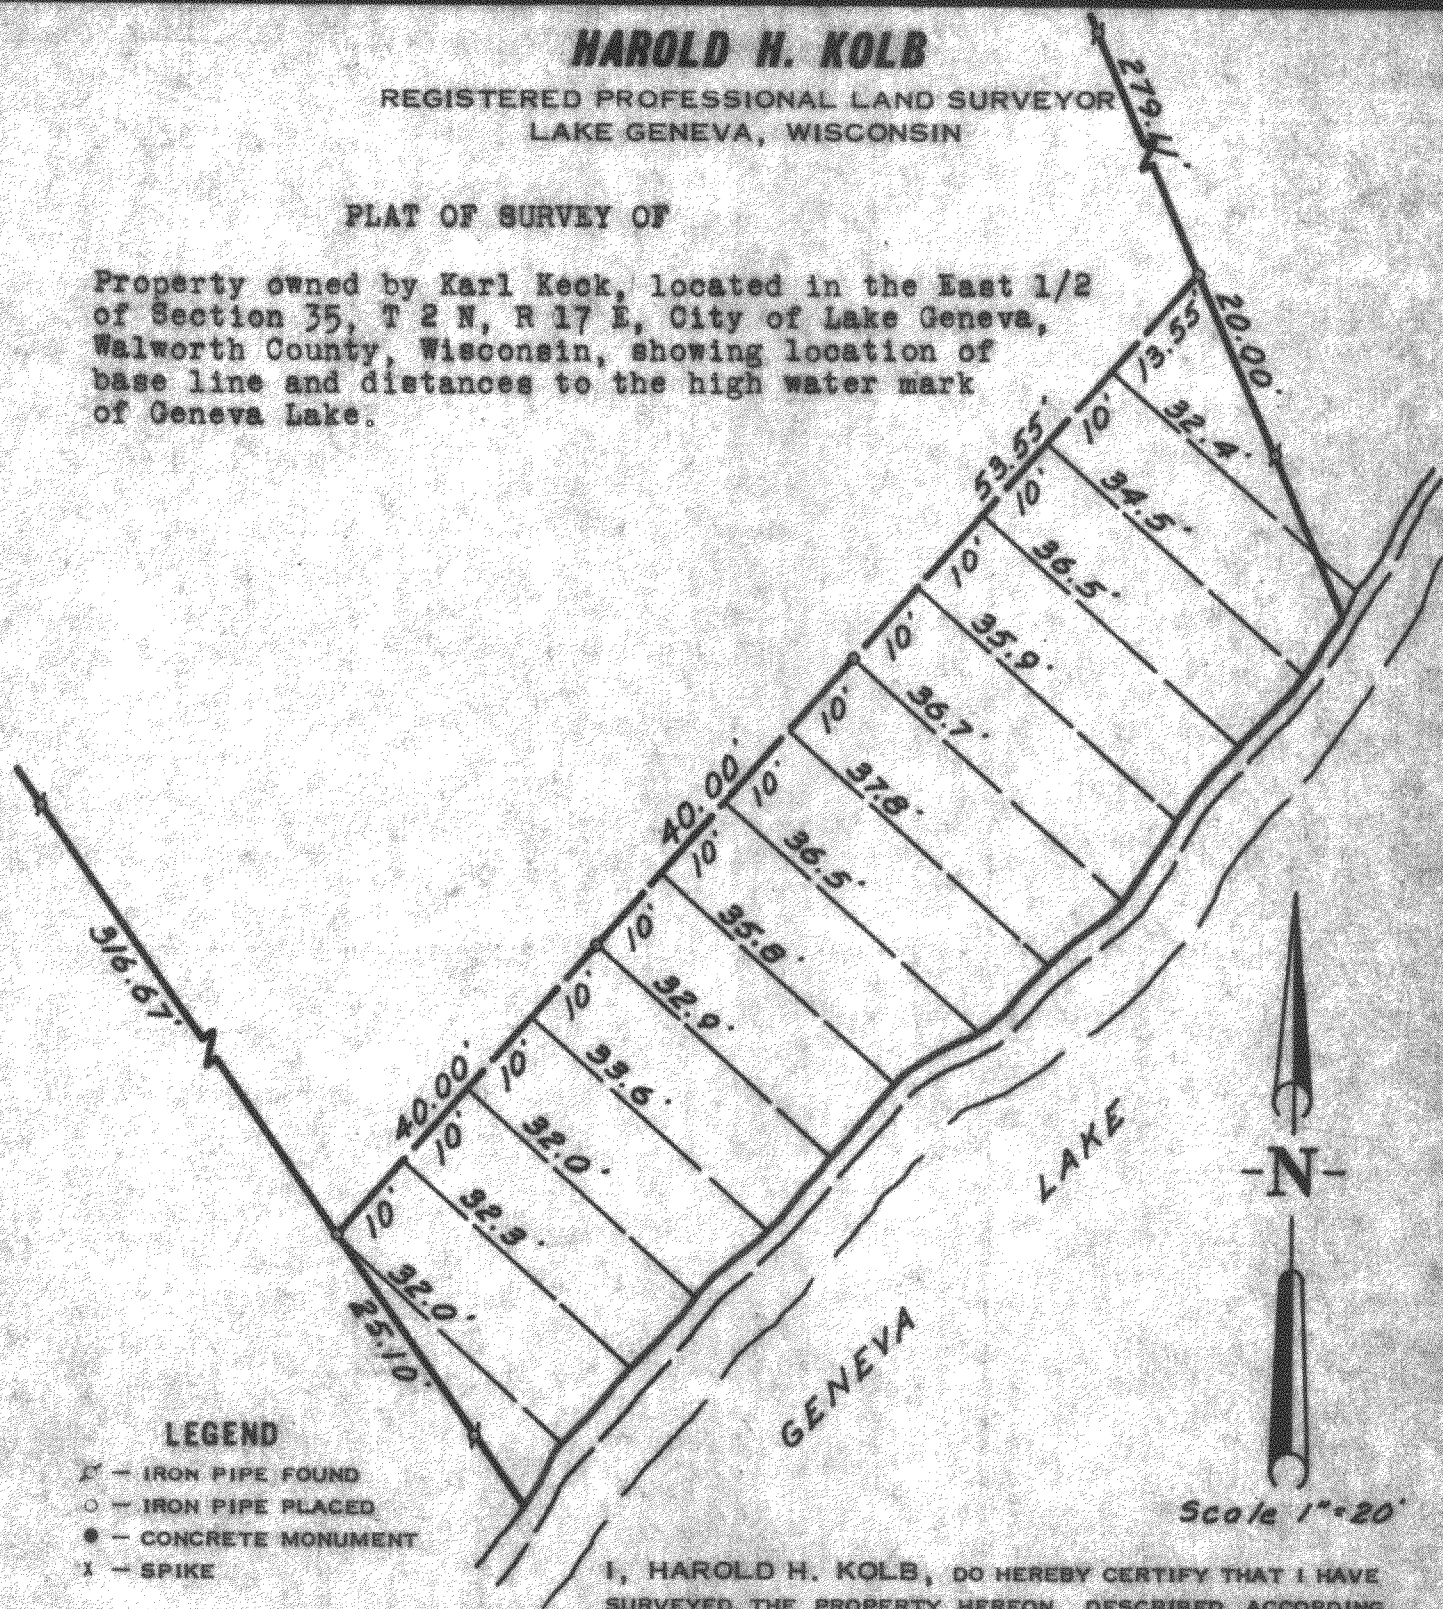

I, HAROLD H. KOLB, DO HEREBY CERTIFY THAT I HAVE SURVEYED THE PROPERTY HEREON DESCRIBED ACCORDING TO THE OFFICIAL RECORDS, AND THAT THE FLAT HEREON IS A CORRECT REPRESENTATION OF THE LOT LINES.

Harold W. Kolb

HAROLD H. KOLB
WISCONSIN REGISTERED LAND SURVEYOR, S-187
DATE September 8, 1964

7-184

VP-94C (shoreline)?