


HAROLD H. KOLB

REGISTERED PROFESSIONAL LAND SURVEYOR
LAKE GENEVA, WISCONSIN

PLAT OF SURVEY OF

A parcel of land located in the Northwest 1/4 of the Southeast 1/4 of the Southeast 1/4 of Section 26, T 2 N, R 17 E, City of Lake Geneva, Walworth County, Wisconsin and described in Volume 589, Page 355, and in Volume 492, page 265, Walworth County Register of Deeds Office, and more particularly described as follows; to wit:
Commencing at the intersection of the centerline of Conant Street and the North-South 1/4 line of said Section 26; thence S 89°21' E 1475.73 feet to the place of beginning; thence N 0°01' W 30.00 feet; thence N 89°21' W 10.00 feet; thence N 0°01' W 170.00 feet; thence S 89°21' E 10.00 feet; thence N 0°01' W 100.00 feet; thence S 89°21' E 65.00 feet; thence S 0°01' E 300.00 feet; thence N 89°21' W 65.00 feet to the place of beginning.

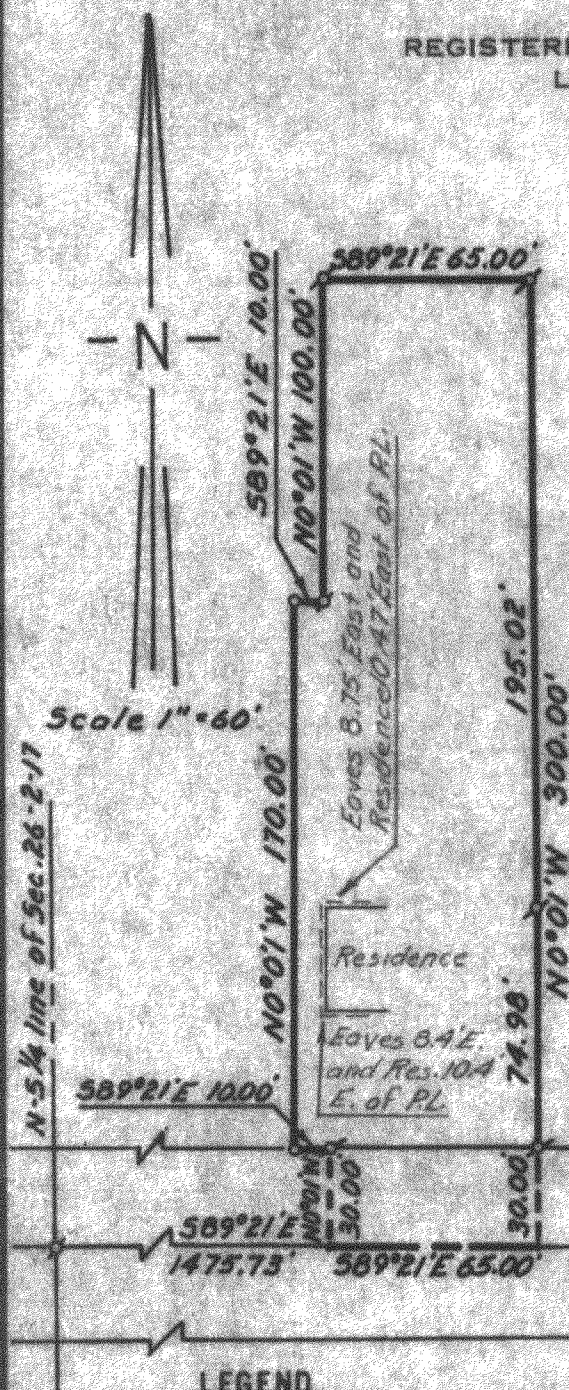

LEGEND

- ⊥ - IRON PIPE FOUND
- - IRON PIPE PLACED
- - CONCRETE MONUMENT
- × - SPIKE

I, HAROLD H. KOLB, DO HEREBY CERTIFY THAT I HAVE SURVEYED THE PROPERTY HEREON DESCRIBED ACCORDING TO THE OFFICIAL RECORDS, AND THAT THE PLAT HEREON IS A CORRECT REPRESENTATION OF THE LOT LINES.

Harold H. Kolb

HAROLD H. KOLB

WISCONSIN REGISTERED LAND SURVEYOR, S-187

DATE October 21, 1964

UP-47B

7-187