


PLAT OF SURVEY

LOT 3 OF BLOCK 17 OF GENEVA LAKE CRAWFORD
MANUFACTURING COMPANY'S ADDITION, CITY OF LAKE
GENEVA, WALWORTH COUNTY, WISCONSIN.

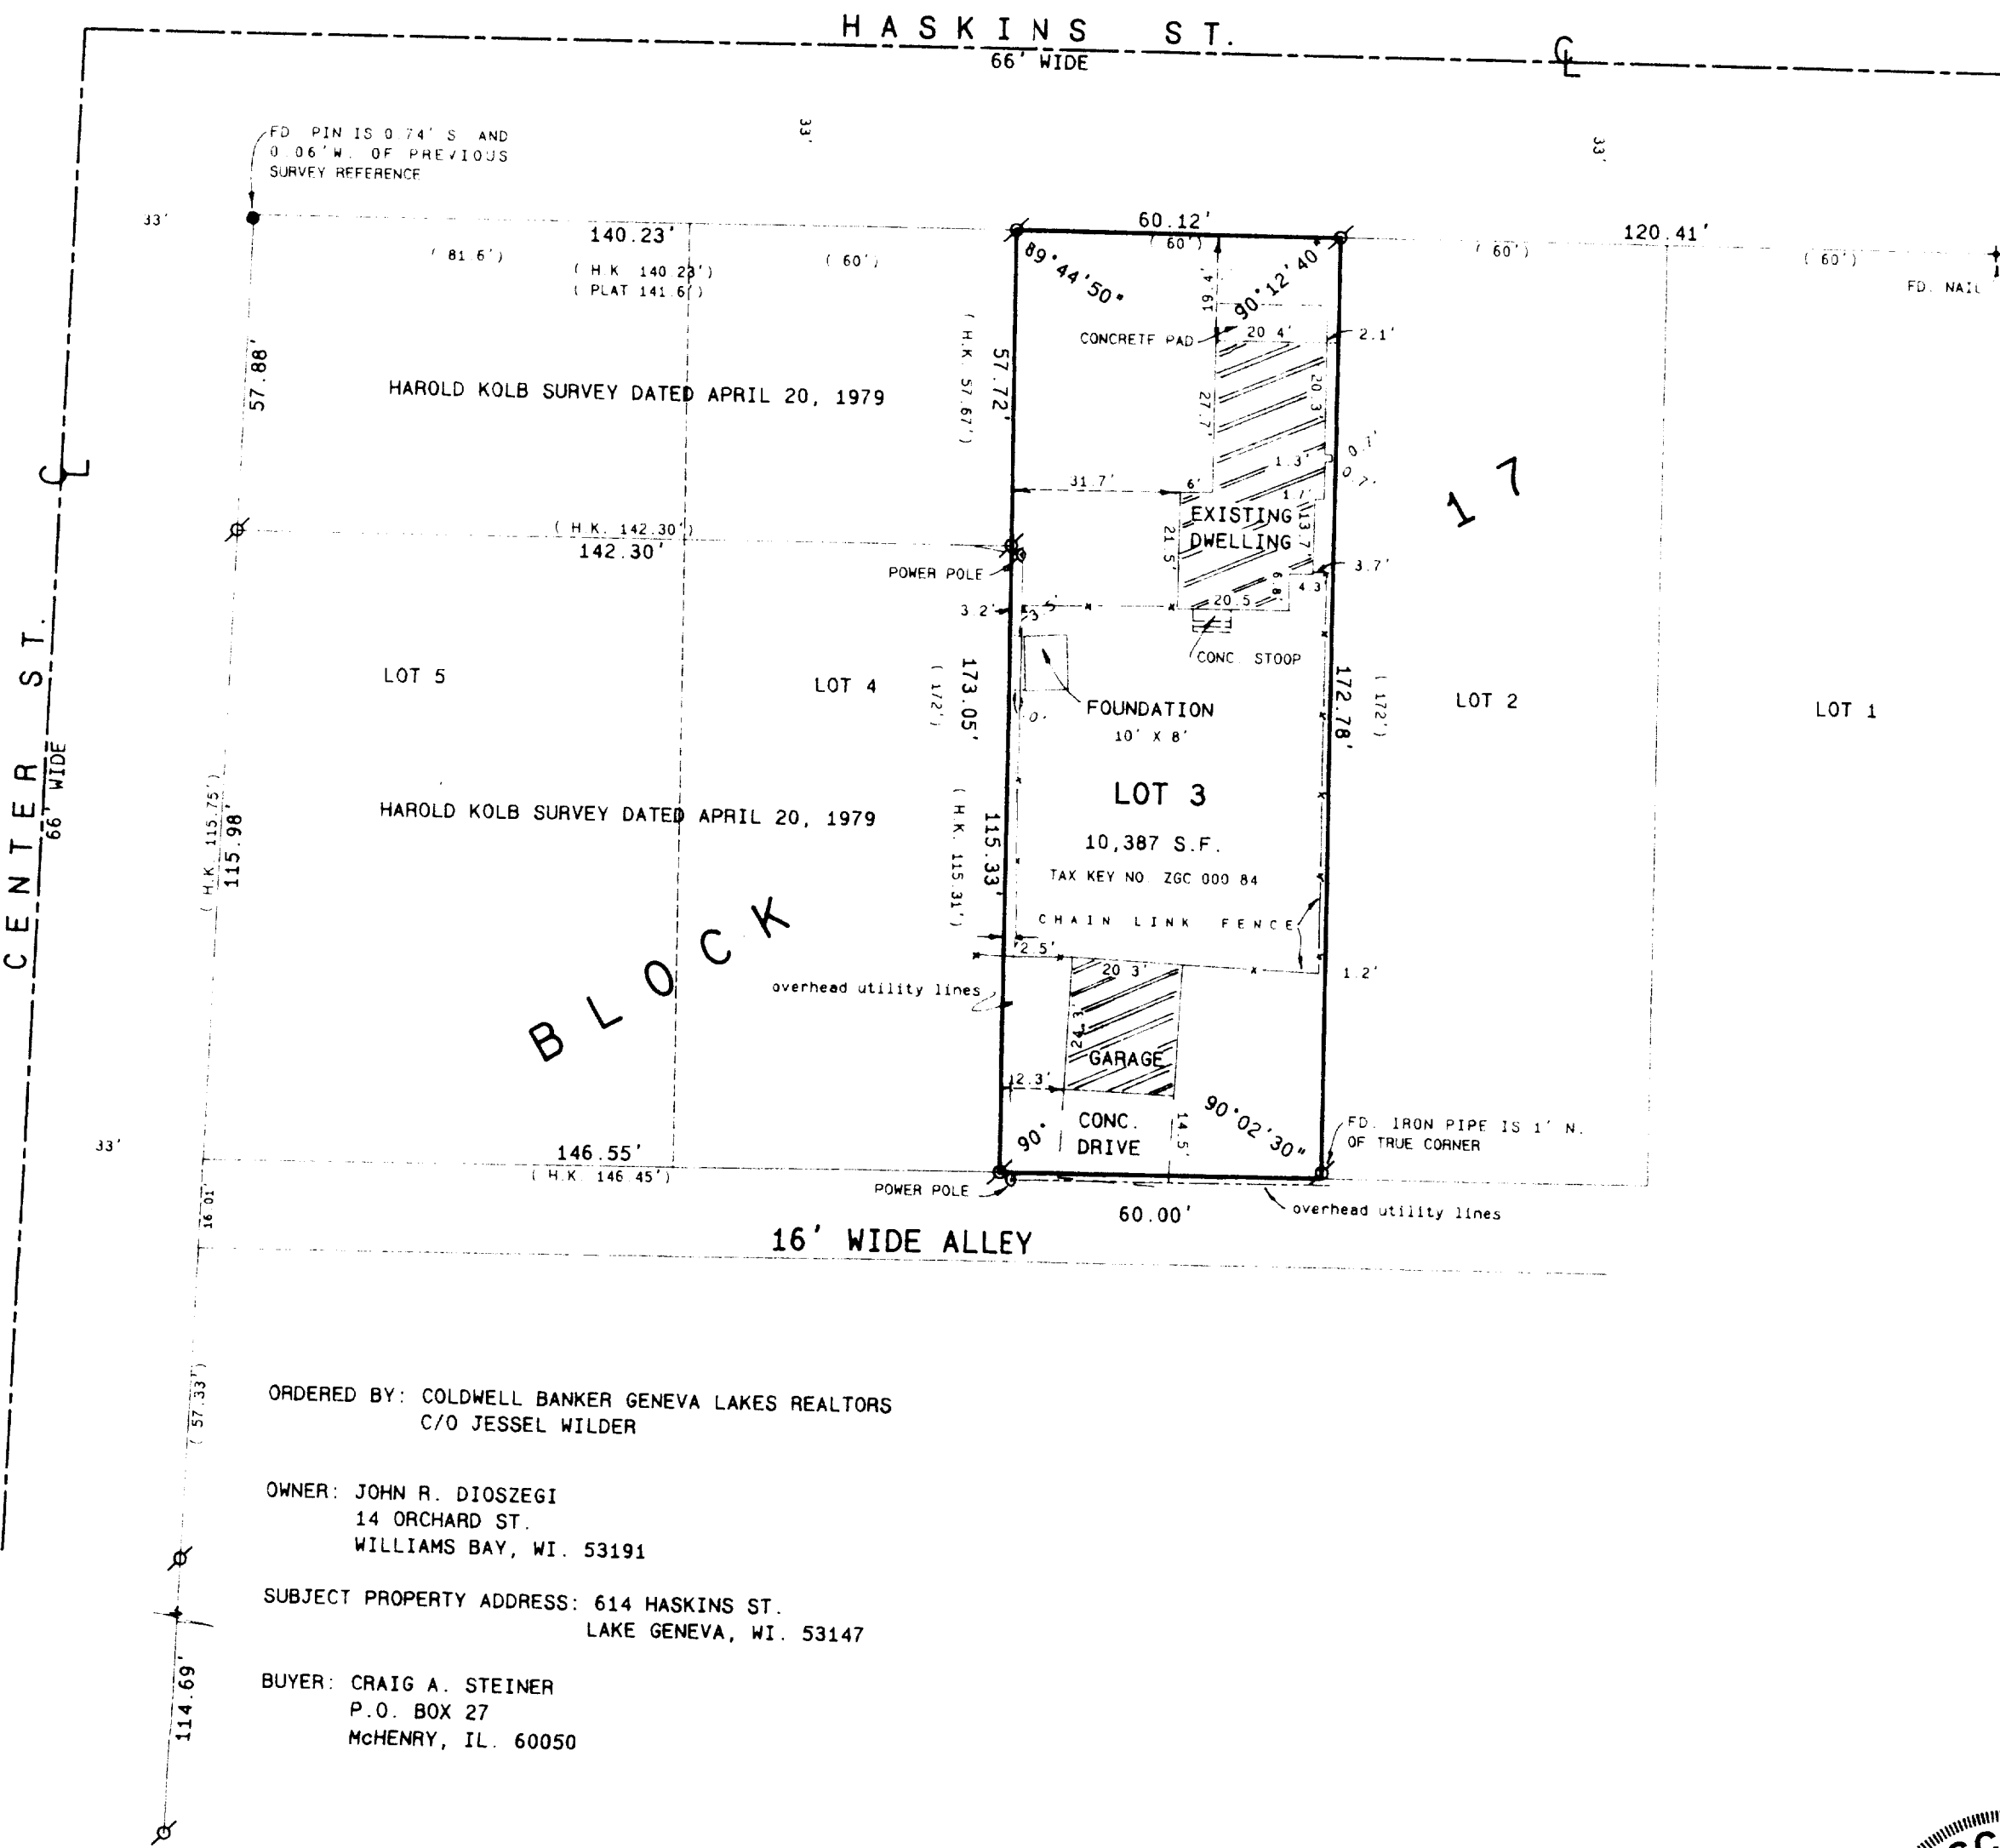

ORDERED BY: COLDWELL BANKER GENEVA LAKES REALTORS
C/O JESSEL WILDER


OWNER: JOHN R. DIOSZEGI
14 ORCHARD ST.
WILLIAMS BAY, WI. 53191

SUBJECT PROPERTY ADDRESS: 614 HASKINS ST.
LAKE GENEVA, WI. 53147

BUYER: CRAIG A. STEINER
P.O. BOX 27
McHENRY, IL. 60050

SCALE 1" = 30 FEET

- Legend
- FOUND IRON PIPE
 - FOUND IRON ROD
 - FOUND BRASS CAPPED MONUMENT
 - FOUND CONCRETE MONUMENT
 - CHISEL CUT IN CONCRETE
 - SET IRON ROD, 24" LONG, WEIGHING 1.5 LBS. LINEAL FT., 3/4" DIA.
 - SET IRON ROD, 30" LONG, WEIGHING 4.5 LBS. LINEAL FT., 1 1/16" DIA.
 - RECORDED AS DIMENSION
 - EXISTING FENCE

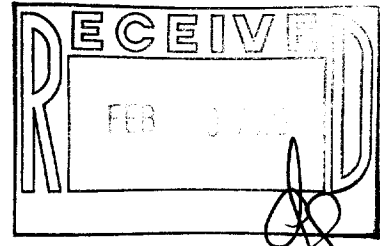

SCALE: 1" = 30 FEET



I hereby certify that the above described property has been surveyed by me or under my direction and that the above map is a true representation thereof and shows the size and location of the property, its exterior boundaries, the location of all visible structures and dimensions of all principal buildings thereon, boundary fences, apparent easements, roadways and visible encroachments, if any.

This survey is made for the use of the present owners of the property and also those who purchase, mortgage or guarantee the title thereto within one year from date hereof.

Kenneth B. Abernathy, Jr.

KENNETH B. ABERNATHY, JR.
WISCONSIN REGISTERED LAND SURVEYOR,
S-1594

Date: SEPTEMBER 10, 1999 Job No. 99.905

200-84

007 1871