


HAROLD H. KOLB

REGISTERED PROFESSIONAL LAND SURVEYOR
LAKE GENEVA, WISCONSIN

CENTER STREET

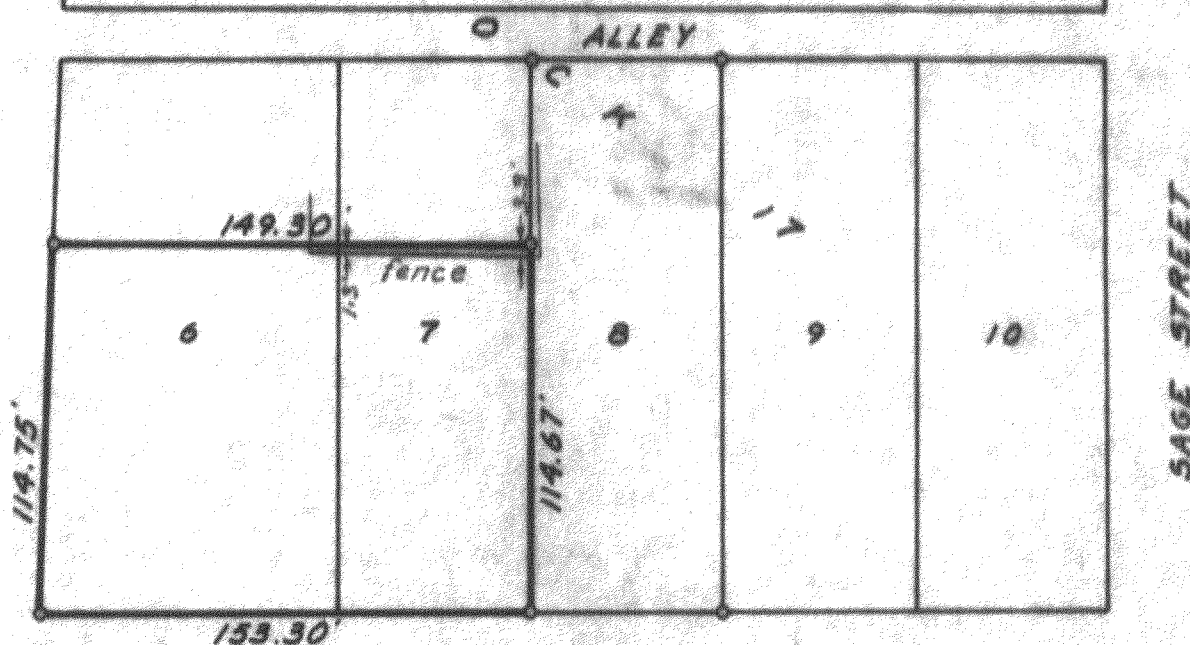

WALWORTH STREET

PLAT OF SURVLY OF

The South 2/3 of Lots 6 and 7, Block 17,
Geneva Lake Crawford Manufacturing Company's
Addition to the Village (New City) of Lake
Geneva, Walworth County, Wisconsin.

N

Scale 1"=60'
LEGEND

- — IRON PIPE FOUND
- — IRON PIPE PLACED
- — CONCRETE MONUMENT
- x — SPIKE

I, HAROLD H. KOLB, DO HEREBY CERTIFY THAT I HAVE
SURVEYED THE PROPERTY HEREON DESCRIBED ACCORDING
TO THE OFFICIAL RECORDS, AND THAT THE PLAT HEREON
IS A CORRECT REPRESENTATION OF THE LOT LINES.

Harold H. Kolb

HAROLD H. KOLB

WISCONSIN REGISTERED LAND SURVEYOR, S-187

DATE November 6, 1964

C 5 1454

7-188

46-137-B