


57-14

291-7

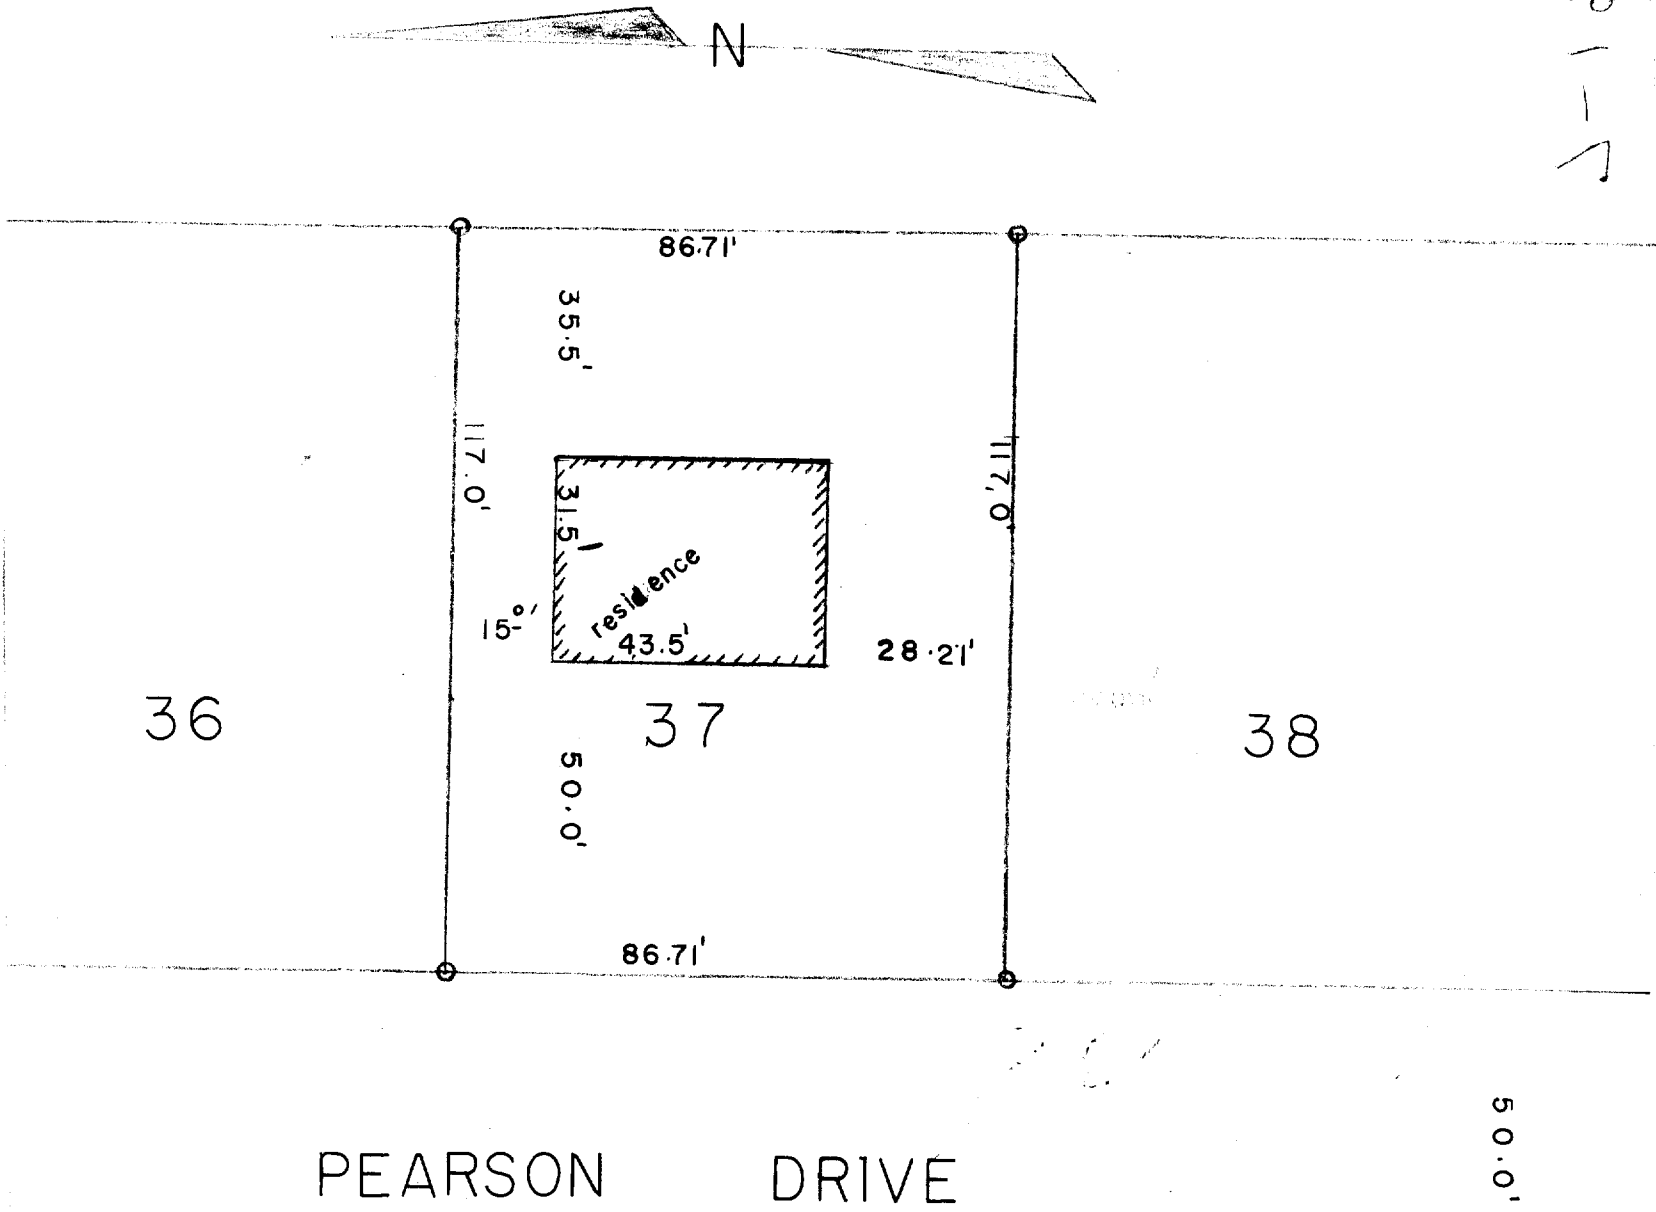

PEARSON DRIVE

DESCRIPTION:

Lot 37, Pearsons Subdivision of a portion of the City of Lake Geneva Walworth County, Wisconsin.

CERTIFICATE:

I, hereby certify that I have on this the 4th day of June 1957 surveyed the above described property according to the official record on file in the office of the Recorder of Deeds in and for Walworth County, Wisconsin, and find that no encroachments exist, and that the residence constructed on this lot as of this day and date, is wholly within the boundaries of said lot.

SIGNED AND SEALED ON THIS THE 5TH DAY OF JUNE 1957

Joseph M. Biagi
Joseph M. Biagi, P.E.
Registered Surveyor
Elkhorn Wisconsin

291-7

29-37

7-199