


ABERNATHY and ASSOCIATES

Kenneth B. Abernathy Jr.

Wisconsin Registered Land Surveyor S-1594


Rt. 3, Box 273
Elkhorn, Wisconsin 53121
Phone: (414) 723-4260 (office)
(414) 723-7209 (FAX)

PLAT OF SURVEY

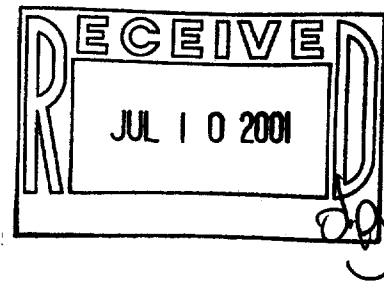

LOTS 7 & 8, BLOCK 21, GENEVA LAKE
CRAWFORD MFG. CO. ADDITION,
LOCATED IN SECTION 25, TOWN 2
NORTH, RANGE 17 EAST, CITY OF
LAKE GENEVA, WALWORTH COUNTY,
WISCONSIN.

OWNER:
JOANNE A. WILLIAMS
307 WATER ST.
LAKE GENEVA, WI 53147

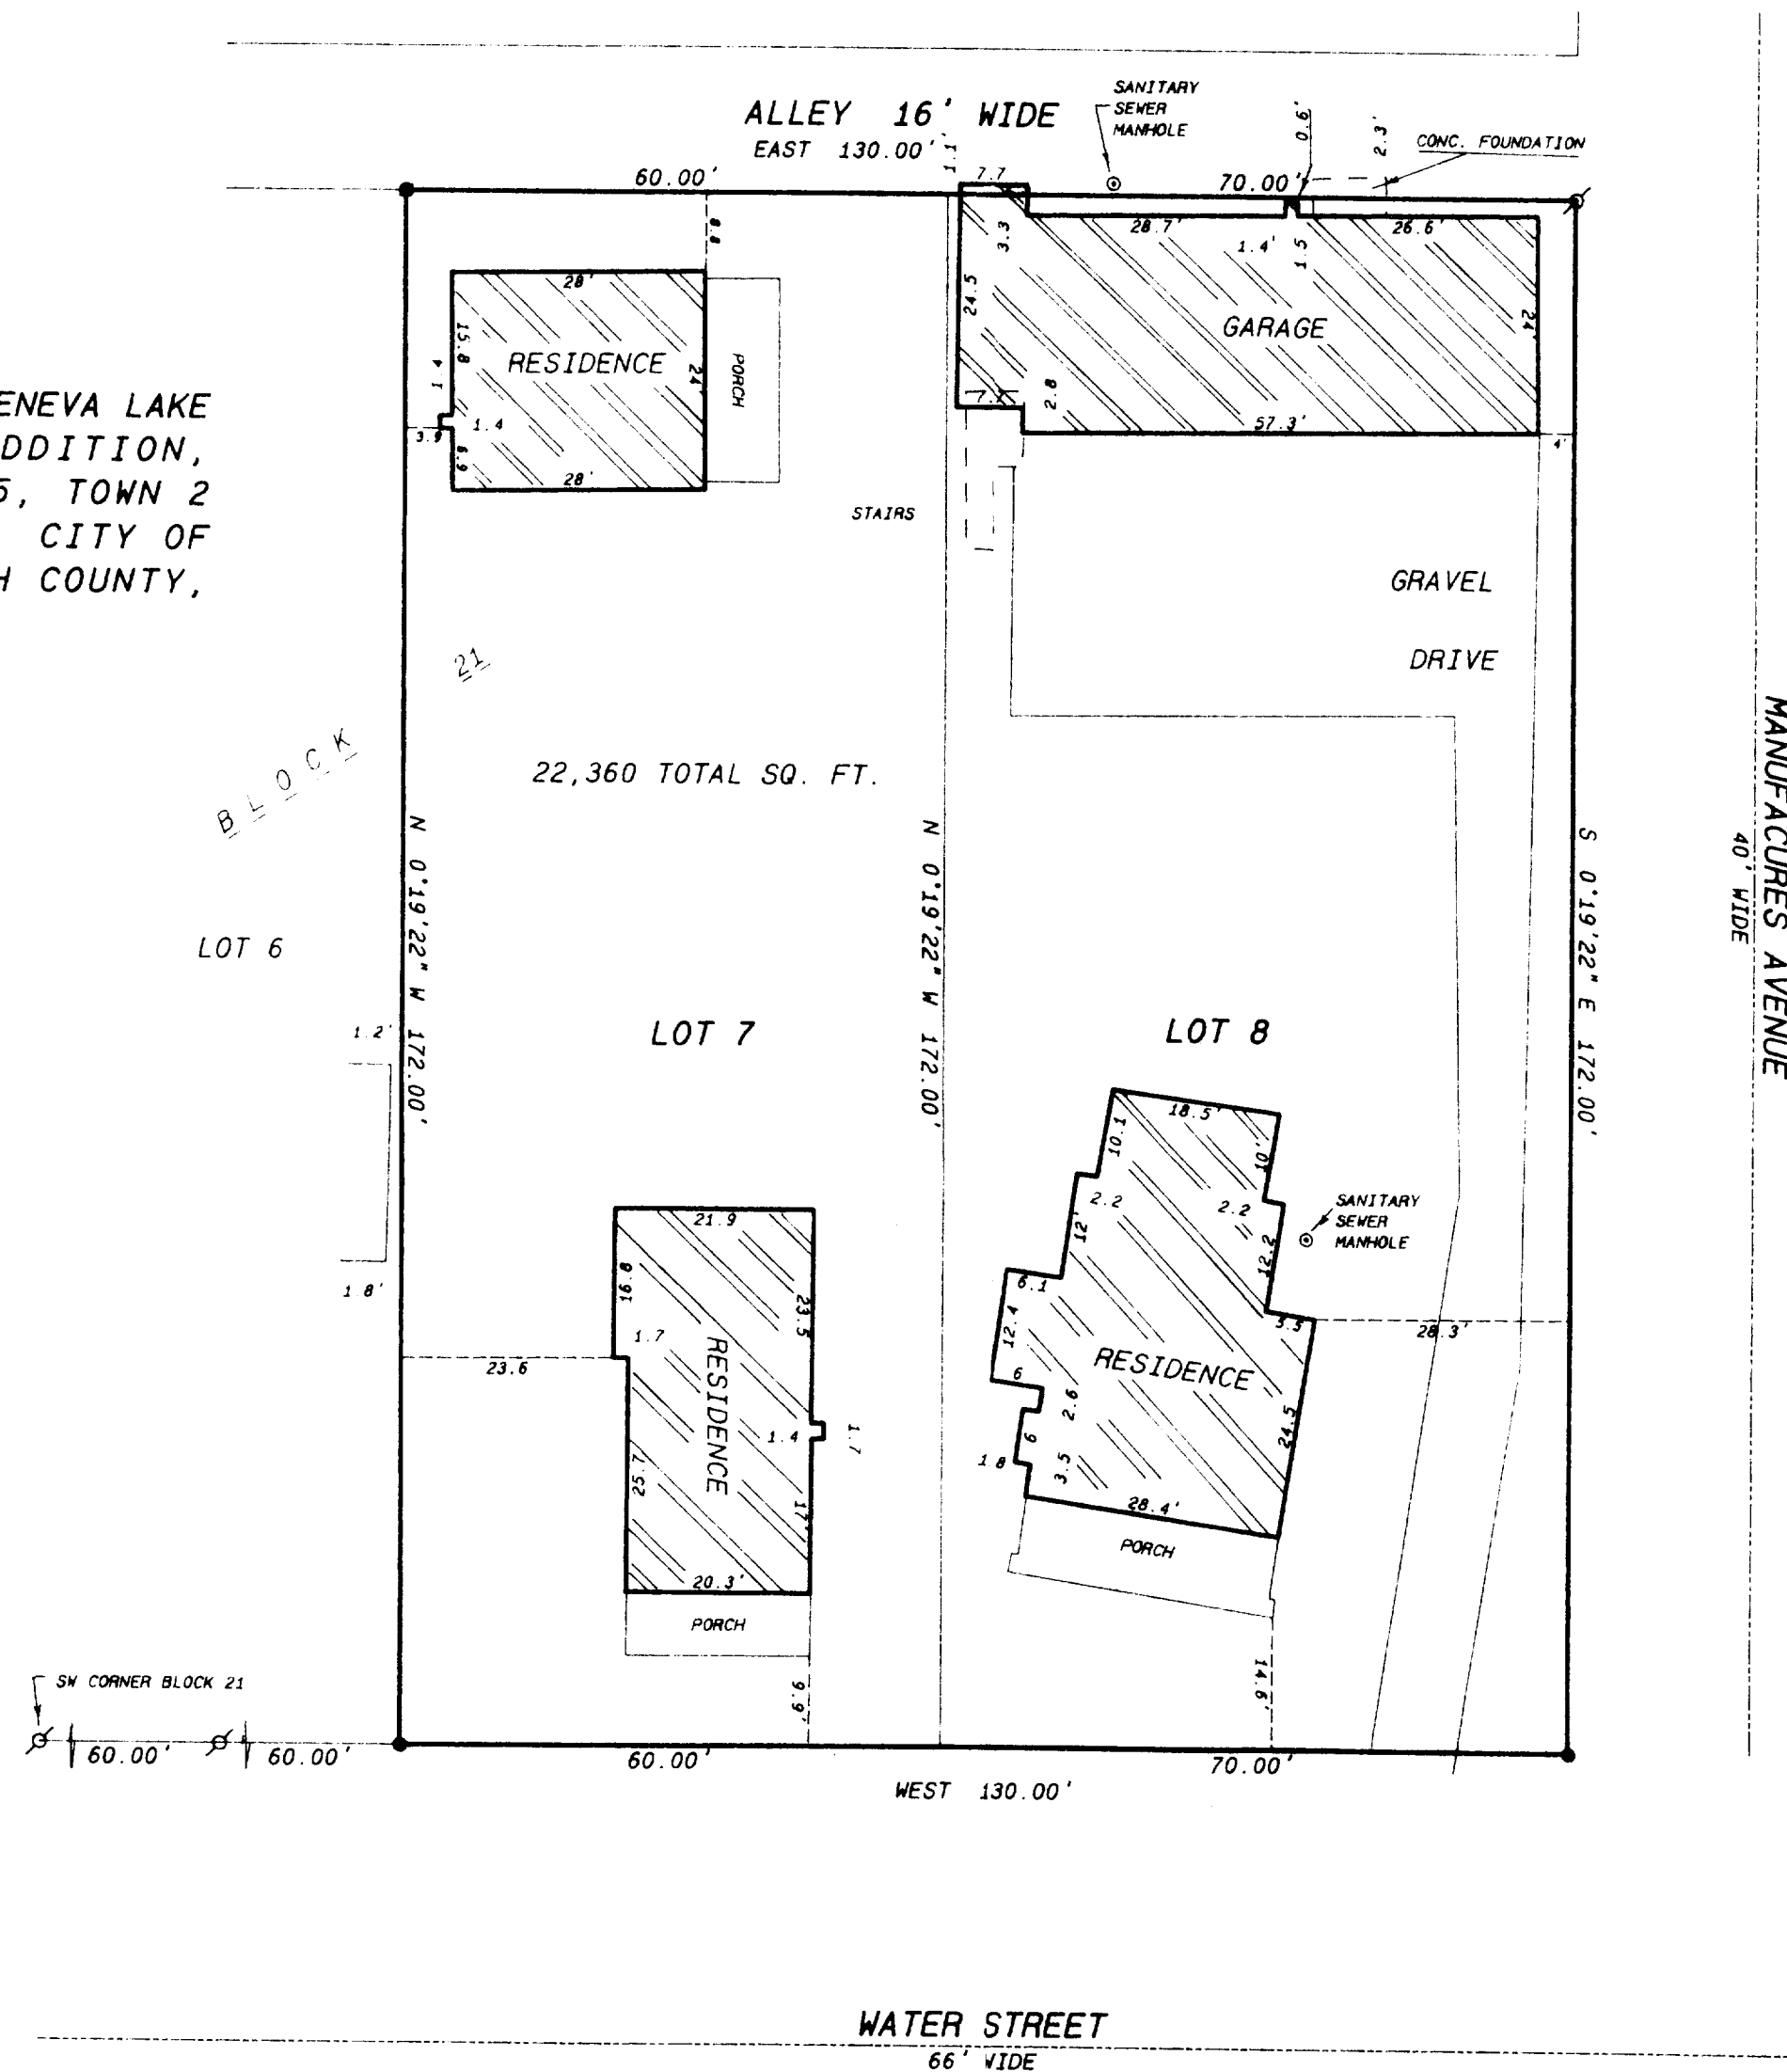

SCALE: 1 INCH = 20 FEET

Legend

- FOUND IRON PIPE
- FOUND IRON ROD
- FOUND BRASS CAPPED MONUMENT
- ✱ FOUND CONCRETE MONUMENT
- ✱ CHISEL CUT IN CONCRETE
- SET IRON ROD, 24" LONG, WEIGHING 1.5 LBS. LINEAL FT. 3/4" DIA.
- SET IRON ROD, 30" LONG, WEIGHING 4.5 LBS. LINEAL FT. 1 1/16" DIA.
- (XXX) RECORDED AS DIMENSION
- EXISTING FENCE



SCALE: 1" = 20 FEET

"I hereby certify that the above described property has been surveyed by me or under my direction and that the above map is a true representation thereof and shows the size and location of the property, its exterior boundaries, the location of all visible structures and monuments of all kinds, including buildings, fences, boundaries, easements, roadways and visible encroachments, if any."

"This survey is made for the use of the present owners of the property and also those who have mortgage, or guarantee the title thereto within one year from date hereof."

Kenneth B. Abernathy, Jr.

KENNETH B. ABERNATHY, JR.
WISCONSIN REGISTERED LAND SURVEYOR,
S-1594

Date: MARCH 12, 2001 Job No. 01-206

007-1976
ZGC-120