


LEGEND:
 ○ - IRON PIPE FOUND
 SCALE 1" = 30'

10.0 10.0

25.00
 25.00

92.80
 15.00
 ALLEY

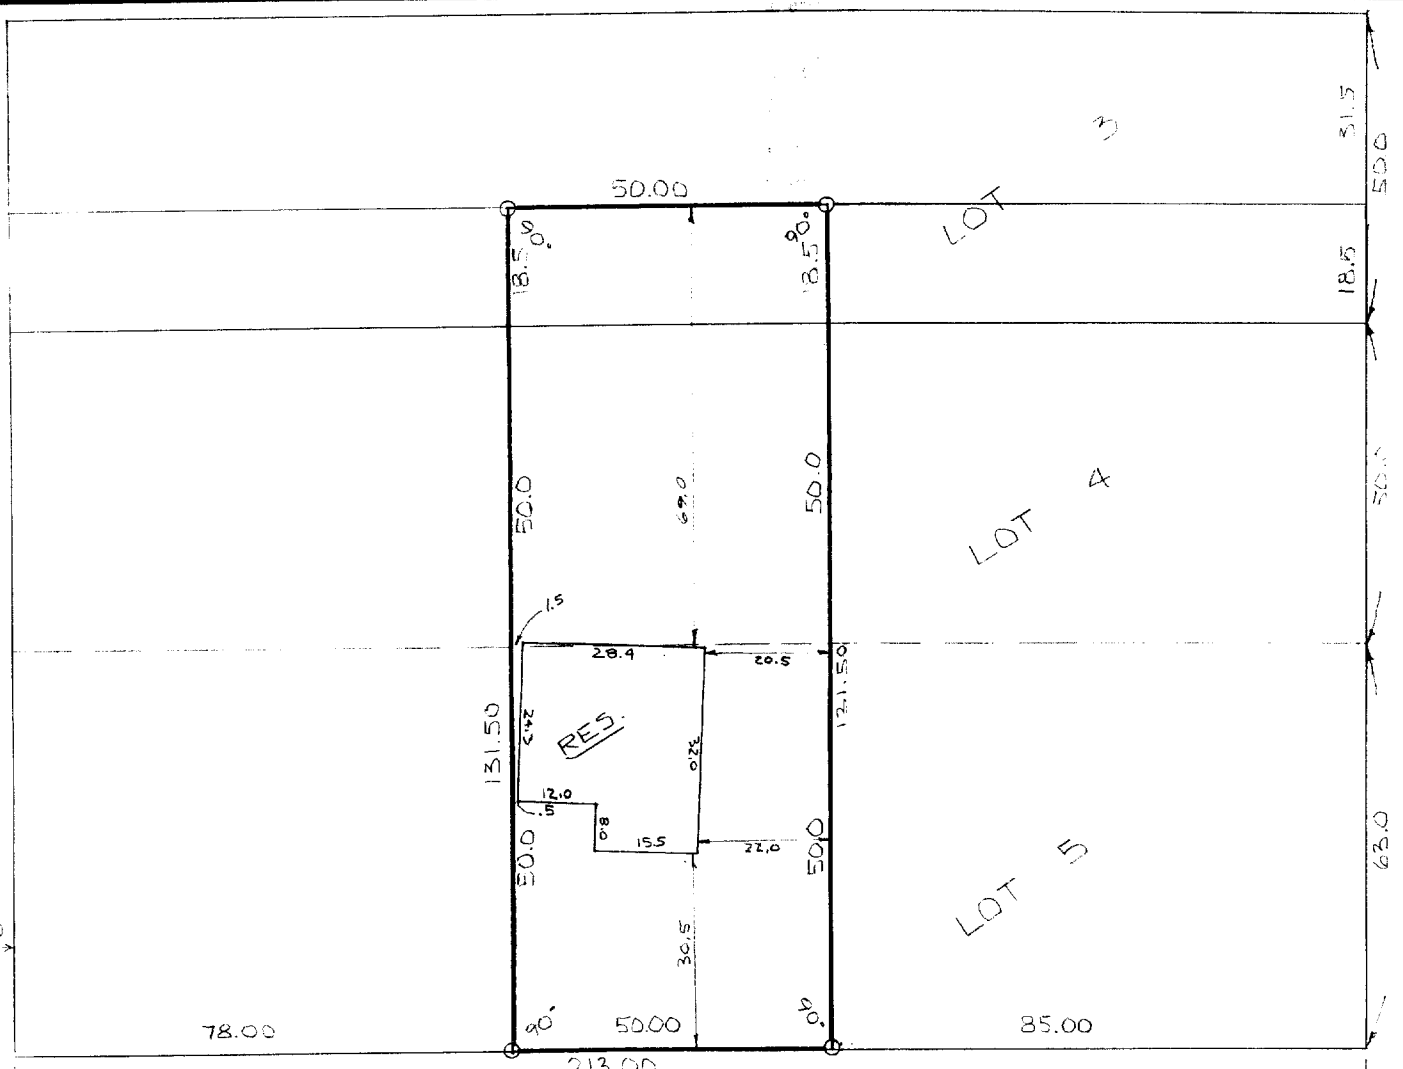

78.00

213.00

85.00

CASS STREET

213.70

33.0

33.0

167.80

DESCRIPTION:

THE EAST 50.00' OF THE FOLLOWING DESCRIBED PROPERTY: THE SOUTH 18 1/2' OF LOT 3 AND ALL OF LOTS 4 AND 5 OF BLOCK 5 EXCEPT THE EAST 85' THEREFROM, PHILLIPS & PURVIS SUBDIVISION, LAKE GENEVA, WISC.

SURVEYOR'S CERTIFICATE:

I, JOSEPH M. BIAGI, SURVEYOR, DO HEREBY CERTIFY THAT I HAVE SURVEYED THE PROPERTY HEREON DESCRIBED.

SIGNED: JUNE 5, 1974

ST.
 CURTIS

Joseph M. Biagi
 JOSEPH M. BIAGI R.L.S. #12
 ELKHORN, WISCONSIN



REVISIONS			GERTRUDE L. PODY PROPERTY		
NO.	DATE	BY	PART OF LOTS 3-4-5 PHILLIPS & PURVIS		
1			DRAWN BY: <i>CPR</i>	SCALE: 1"=30'	MATERIAL
2					
3			CHK'D	DATE: 6-5-74	DRAWING NO. #34-74
4					
5			TRACED	APP'D	