

7-2042

# Plat of Survey

of




## Lots 3 and 4 of Block 2 of Warhurst's Subdivision,

located in the Southwest 1/4 of Section 25, Town 2 North, Range 17 East,  
City of Lake Geneva, Walworth County, Wisconsin.


Surveyed for: **Keefe Real Estate, Inc.**

P.O. Box 460  
Lake Geneva, Wisconsin. 53147

Survey Date: May 29, 2001.  
Revisions:

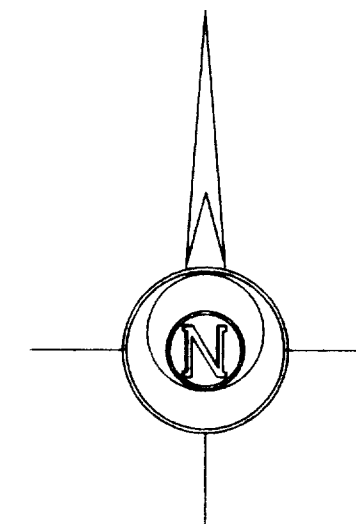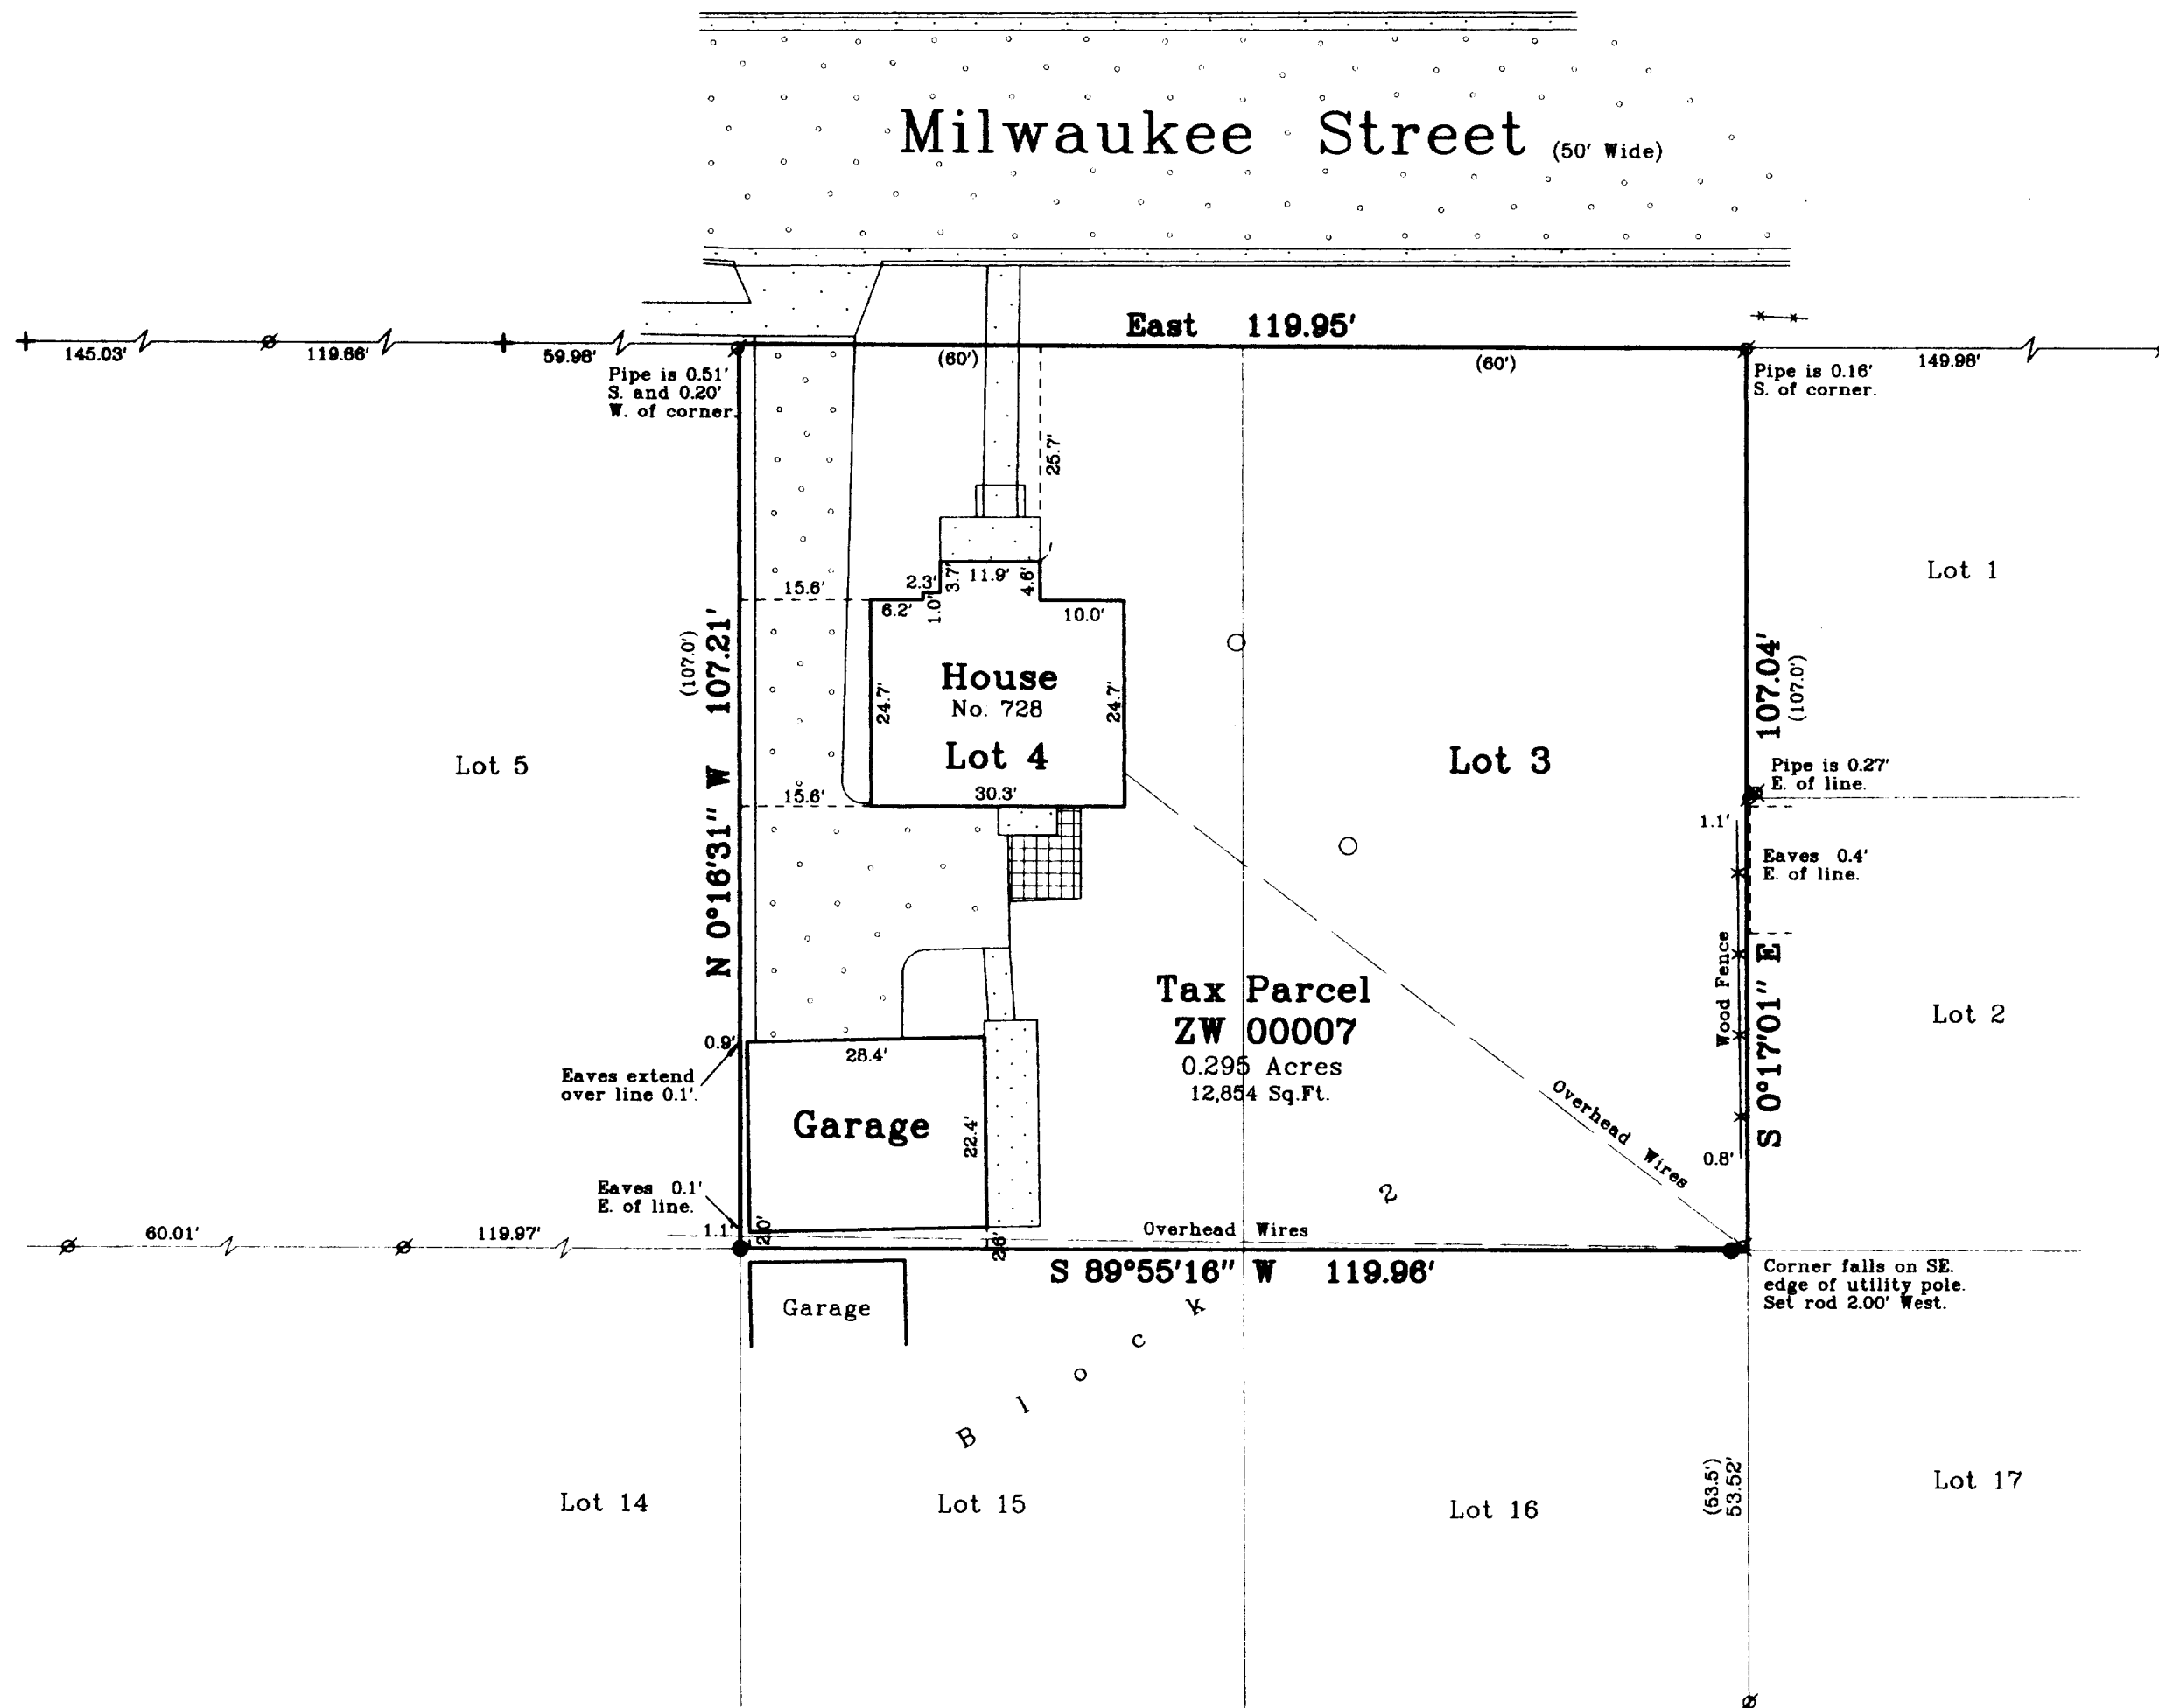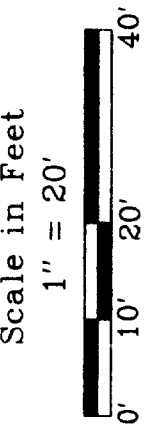


Bearings referenced to the South line  
of Milwaukee Street, assumed as East.

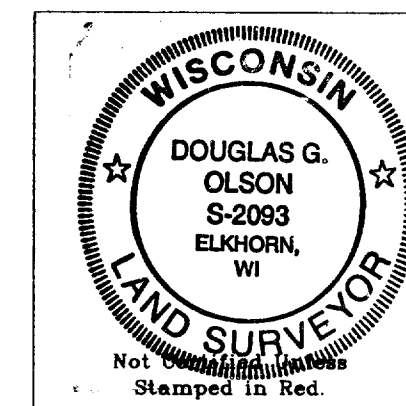

Notes: 1) This survey plat is not  
certified unless signed  
and sealed in red ink.

2) This survey is subject to Wisconsin lien laws.  
This Plat of Survey is the notice of intent  
to file lien. Lien waiver required.

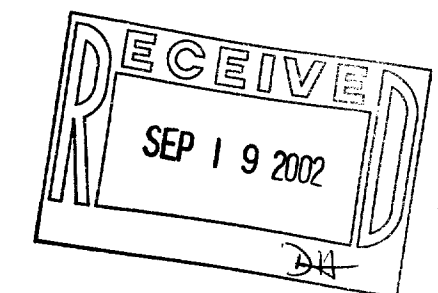

Copyright © 2001 by Jensen & Olson Land Surveying, LLC.

All rights reserved. No part of this survey plat may be reproduced  
or transmitted in any form by any means - graphic, electronic, or  
mechanical, including photocopying, tracing, or information storage  
and retrieval systems - without permission in writing from Douglas  
G. Olson, Jensen & Olson Land Surveying, LLC.

I hereby certify that I have surveyed the above described  
property and the map hereon is correct to the best of my professional  
knowledge and belief and shows the size and location of the property,  
its exterior boundaries, the location and dimensions of all visible  
structures thereon, boundary fences, apparent easements and roadways  
and visible encroachments, if any.  
This survey is made for the exclusive use of the present owners  
of property, and also those who purchase, mortgage or guarantee title  
thereto, within one year from the date hereof.

Douglas G. Olson  
Wisconsin Registered Land Surveyor - 2093

**Jensen & Olson Land Surveying, LLC**  
45 South Wisconsin Street  
Elkhorn, Wisconsin. 53121  
Telephone (262) 723-3434  
Facsimile (262) 723-8044

Legend  
+ Found Iron Pipe  
x Found Chiseled Cross  
● Set Iron Rod  
○ Set Iron Stake  
x Utility Pole  
x Asphalt Surface  
x Concrete Surface  
○ Metal Cover  
x Brick Patio

Sheet 1 of 1 Sheets  
Job Reference Number  
**2001.063**  
2001.063

7-2042