


44-~~100~~
the
nge
Wisconsin.

Signed and sealed on this the 12th day of June 1944.

Joseph M. Biagi
Joseph M. Biagi

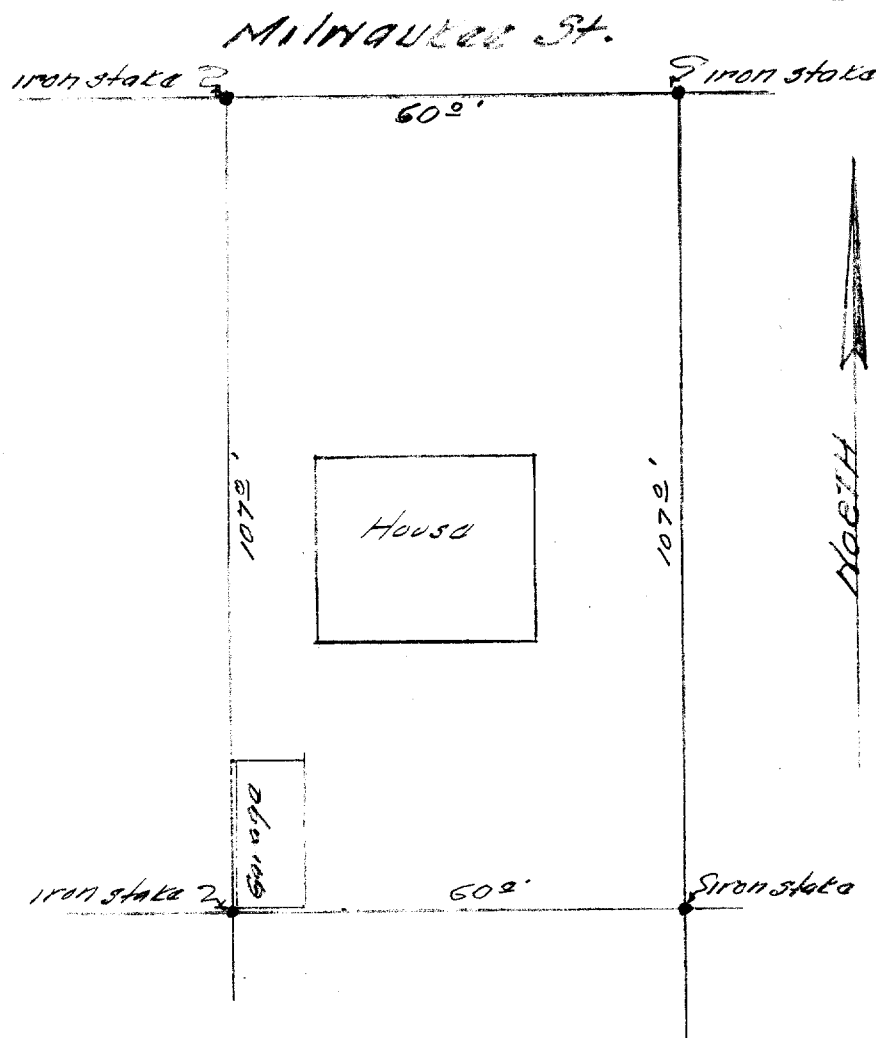

SURVEY
OF
Lot 5 Block 2
Warhurst's Addition
to the
CITY OF LAKE GENEVA
Walworth County Wis.

1700
2000
3000
4000
5000
6000
7000
8000
9000
10000

7-206B