


CP-336
345

Proposed survey for L.O. Nutini

Mar. 4, 1920

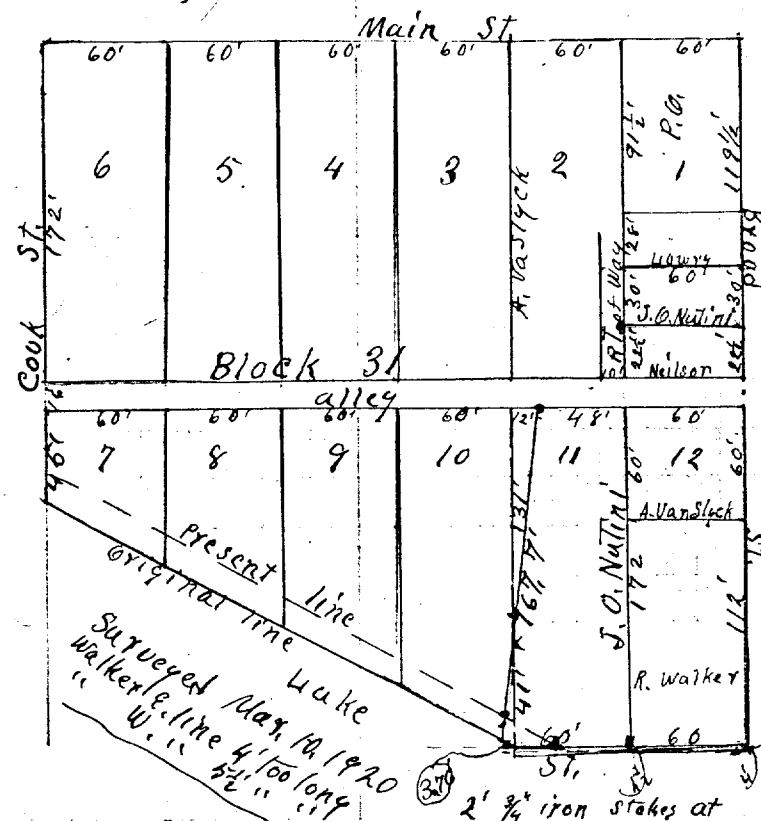

Descriptions from deeds.

Commencing at a point in East line of Lot 6 ne; Block 31, 119 1/2' South of N.E. Cor. of said lot 1; thence west parallel with N. line of Block 31, 60'; thence S. in W. line Lot 1, 30'; Thence E, 60' parallel to said N. line of Block 13, to E. line of Lot 1; thence N. in said E line 30'

7-207-SK

34

To place of beginning, and
 it of way in Lot 2, 10' wide to
 alley in said Block.

Description 2nd

All of Lots 10 & 11 in Block
 31 East of a straight line
 drawn from a point in N. line
 of Lot 11, in said Block, 12 E.
 of N. W. Cor. of Lot 11. Thru
 a point in the W. line of Lot 11,
 41' N. of the S. W. Cor. of
 Lot 11, to the South line of
 Lot 10. Said last point, is
 3.76' West of S. W. Cor. of Lot 11.
 Original plat shows Lots 11 & 12
 are full lots, and W. line
 of Lot 7, by proportional
 division was originally 45'

On Mar. 9 & 10. Surveyed both
 lots described in deeds above.
 N. line of P. Q. and E. line of P. Q.
 used as meridian or base line.
 Transit line, E. line P. Q. extended
 shows Nutini's, Neilson's & garage
 lines out 10' to 11'.

Walker & Lowry front line
 O. K.

Measured E. line Block 31, shows
 Walker ~~line~~ E. line 116' instead
 of 112, and W. line 117½, making
 Walker & Short S. lines 4 & ½'
 too far south.

Transit line at S. end 112' E line
 W. to West line Short-Nutini
 strikes inner walk line 53.6 W. of
 E. line, S. W. Cor. of Lot 11, is
 in center of walk.

S. line of Short-Nutini ~~102~~ 102' Ept.
 should be 63.75, so set. North
 line 48', so set and marked
 by ¾" 2' iron stake.

Transit line from N. W. Cor. to
 S. W. point and iron stake
 set at inner walk line &
 June, with Lone walk also
 at 65.8' N. on west line.

Lone - short line correct as occupied
 own stake on E. line 5½' N of Walk.
 and at line of Walker fence,
 also on S. line 43.6' west of Walker
 line, and at inner walk line
 11.2' from S. W. Cor. stake.

over - on bottom of page

Nutini 2nd survey
 Measured $119\frac{1}{2}$ ' S. from N.E. cor. P. 6. for
 N.E. cor. Nutini. 6. k. at mid. of
 Nutini-Lowry party wall.
 30' S. for S.E. cor. 6 k. at
 Nelson wall.

Measured west 60. at alley and
 S. line of P. 6. and $119\frac{1}{2}$ ' S.
 from N.P. 6. line and lined with alley
 stake Lowry-Nutini wall 6. k. south
 30. ft. Nutini S. line 6. k. W. line 5" E.
 Iron stake S.W. cor. Notch in wall at front.