


PLAT OF SURVEY

DESCRIPTION:

LOTS 6, 7, 8, 9 AND PART OF LOT 10, BLOCK 26 OF
THE ORIGINAL PLAT OF THE CITY OF LAKE GENEVA,
WALWORTH COUNTY, WISCONSIN.

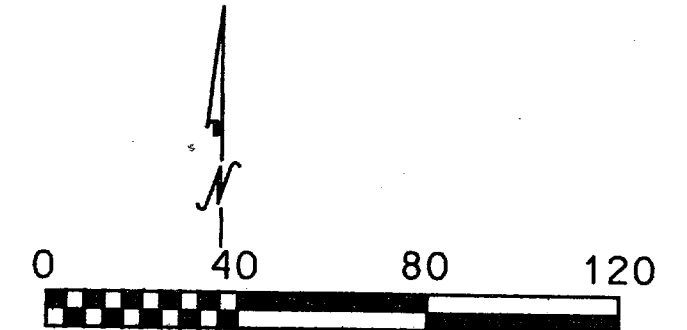


SCALE 1" = 40'


RECERTIFICATION
DATE: 10/24/2005

FOR: KEEFE ASSOCIATES

COOK STREET

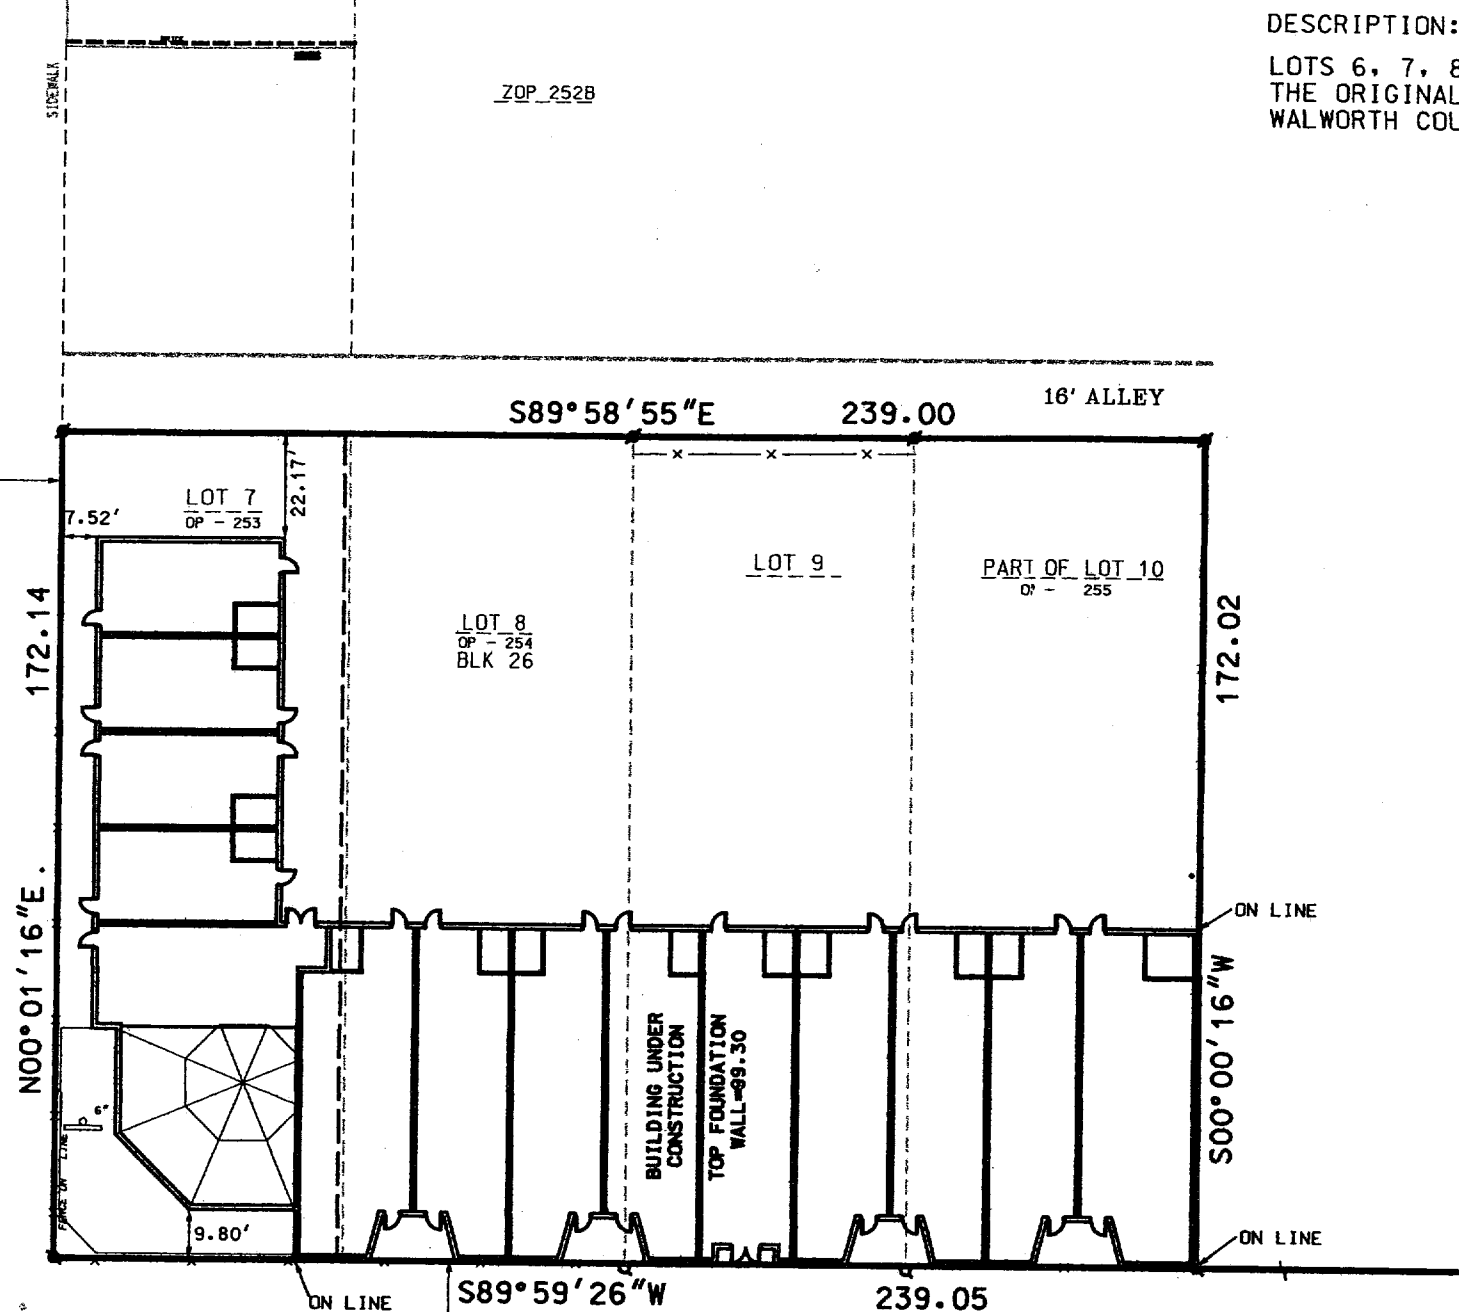

I PAUL H. VAN HENKELUM R.L.S. # 1931 HEREBY
CERTIFY THAT THIS SURVEY WAS MADE IN
ACCORDANCE WITH THE MINIMUM STANDARDS FOR
PROPERTY SURVEYS (CHAPTER A-E7) STATE OF
WISCONSIN AND HAS BEEN PREPARED UNDER MY
DIRECTION AND CONTROL AND IS CORRECT TO THE
BEST OF MY KNOWLEDGE AND BELIEF.

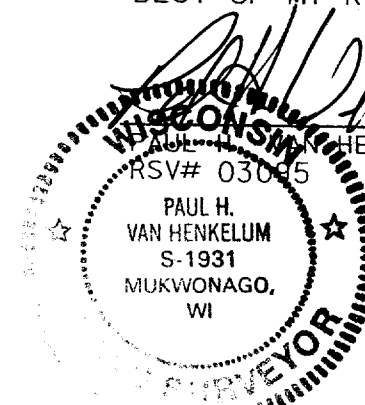

10/24/05

PAUL H. VAN HENKELUM, R.L.S. # 1931

MAIN STREET

ZOP-254 ZOP255

007-2377

RSV
ENGINEERING, INC.

Engineers Land Surveyors Environmental Scientists
801 MAIN STREET MUKWONAGO, WISCONSIN 53149 (262)363-2004

BR0105037 000087/000955 SITE REPORT.DGN 10/24/2005