



PREPARED FOR:
LAURA RODRIGUEZ
COLDWELL BANKER PRIMUS
226 BROAD STREET
LAKE GENEVA, WI 53147

PLAT OF SURVEY

-OF-

LOT 12, H.E. WELLS ADDITION TO THE CITY OF LAKE
GENEVA, WALWORTH COUNTY, WISCONSIN.


PATHFINDER SURVEYING INC.
W2888 KRUEGER ROAD, UNIT "D"
LAKE GENEVA, WI, 53147
262-248-3697

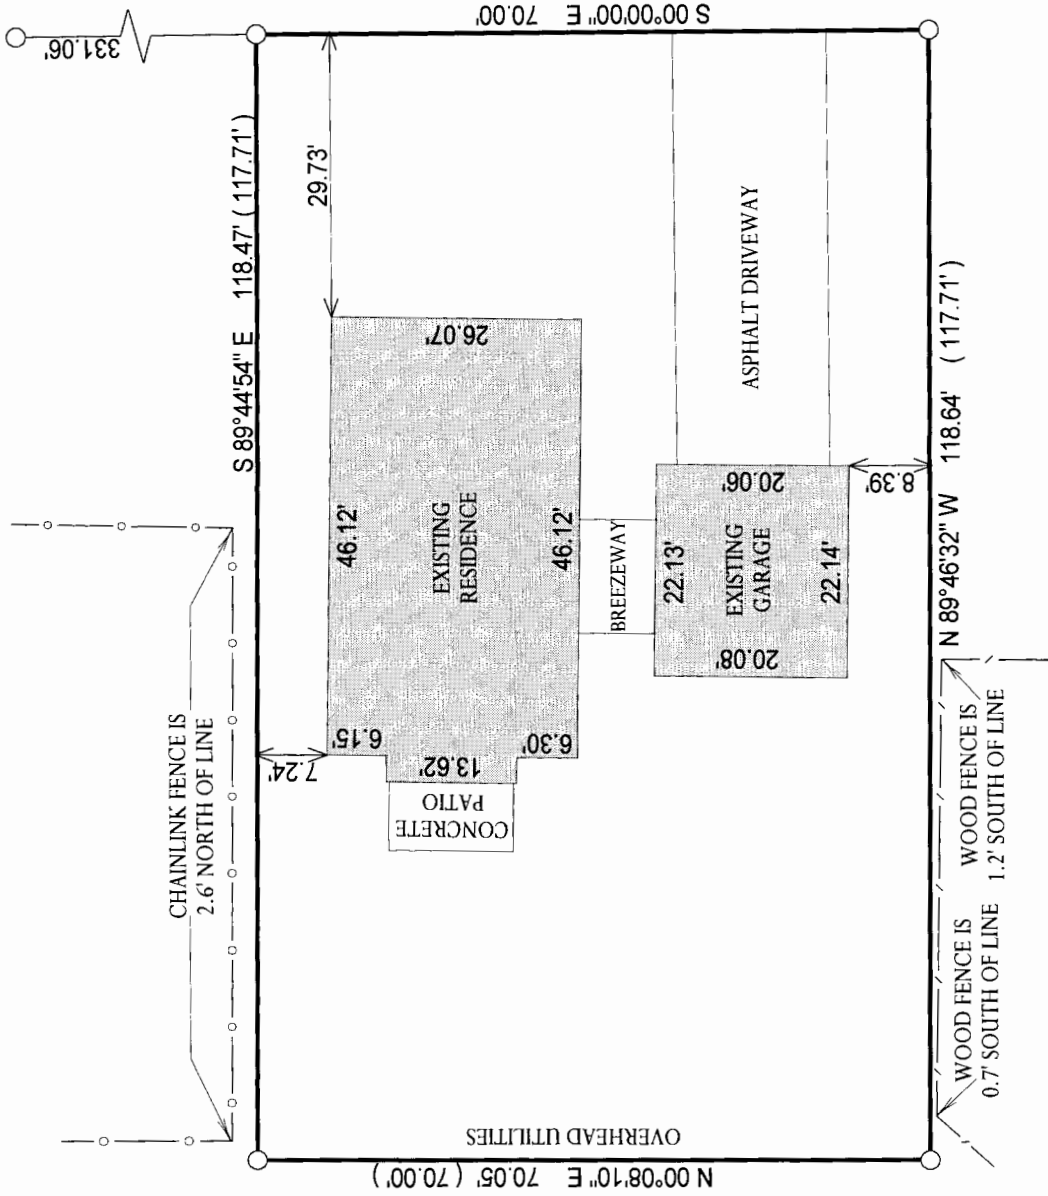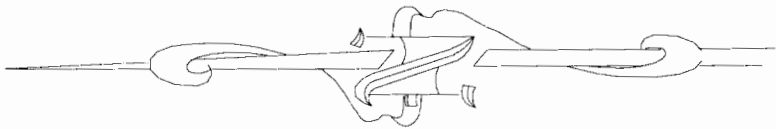

LAKE GENEVA BOULEVARD
(60' WIDE)

JUL 28 2006

807

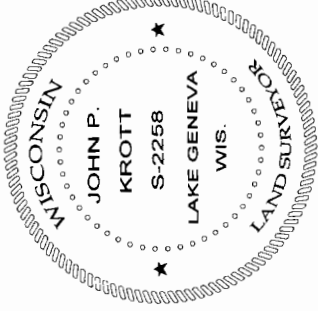

NOTE: BASIS OF BEARING IS LAKE
GENEVA BLVD ASSUMED NORTH-SOUTH.

"I hereby certify that the above described property was surveyed under my supervision and that the above map, to the best of my knowledge and belief, is a true representation thereof and shows the size and location of all visible structures, apparent easements and encroachments if any." This survey is made for the present owners of the property, and those who purchase, mortgage, or guarantee the title thereto, within one year from the date hereof.

JOHN KROTT S - 2258
Wisconsin Registered Land Surveyor
(original if signed in red)

John P. Krott

DATED THE 13th DAY OF JUNE, 2006.

- () = RECORDED AS
- = FOUND IRON BAR
- = FOUND IRON PIPE
- = SET IRON PIPE
- = SET IRON BAR

SCALE: 1" = 20'

JOB #: 06-289

TAX ID #: ZWE 00012

007-2423