PREPARED FOR VIRGIL WUTTKE W3954 BRAY RD. ELKHORN WI. 53121


PLAT OF SURVEY

-OF-

KROTT SUR VEYING INC.

N3705 WILLOW BEND LANE
LAKE GENEVA WI. 53147
PHONE # (262)248-3697
FAX # (262)249-0639

LOT 9, OF BLOCK 17 IN THE ORIGINAL PLAT OF THE VILLAGE (NOW CITY) OF LAKE GENEVA, WALWORTH COUNTY, WISCONSIN.

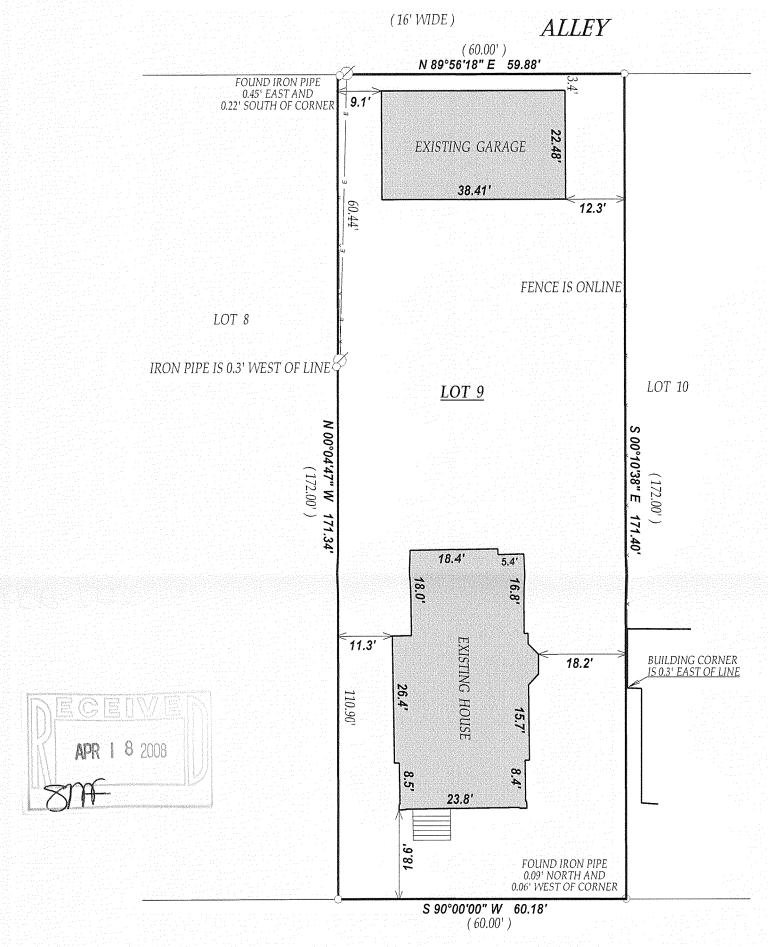


GENEVA STREET

NOTE : DUE TO SNOW COVER ALL IMPROVEMENTS MAY NOT BE SHOWN NOTE : GENEVA STREET WAS ASSUMED TO BEAR EAST-WEST

LEGEND

- O FOUND IRON PIPE
- SET IRON BAR
- Ø POWER POLE
- —E—OVERHEAD WIRES
- (XX) RECORDED AS


JOB # 08-017 TAX ID # ZOP00171
DATED THIS THE 12th DAY OF FEBRUARY 2008.

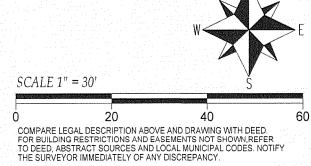

THE SURVEYOR IMMEDIATELY OF ANY DISCREPANCY.

"I hereby certify that I have surveyed the above described property and that the above map is a true representation thereof and shows the size and location of all visible structures, apparent easements and encroachments

This survey is made for the present owners of the property, and those who purchase, mortgage, or guarentee the title thereto, within one year from the date hereof.

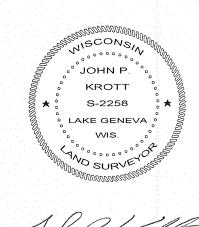

JOHN KROTT S - 2258
Wisconsin Registered Land Surveyor

(original if signed in red)