


ASSIGNED THE EAST LINE OF OUTLOT 1  
N 00°13'12" W

# PLAT OF SURVEY OUTLOT 1 AND LOT 2 OF CERTIFIED SURVEY MAP NO. 1485

LOCATED IN THE SOUTHWEST 1/4 OF THE SOUTHEAST 1/4 OF SECTION 26, TOWN 2 NORTH,  
RANGE 17 EAST, CITY OF LAKE GENEVA, WALWORTH COUNTY, WISCONSIN

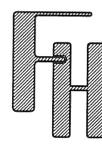


PLAT OF SURVEY

WORK ORDERED BY -  
LEONARD JEGERSKI  
1804 CONANT STREET  
LAKE GENEVA, WI 53147

FARRIS, HANSEN & ASSOCIATES, INC.  
ENGINEERING - ARCHITECTURE - SURVEYING  
7 RIDGWAY COURT P.O. BOX 437  
ELKHORN, WISCONSIN 53121  
OFFICE: (262) 723-2088 FAX: (262) 723-5686

REVISIONS

PROJECT NO.  
7614  
DATE  
05/28/2008  
SHEET NO.  
1 OF 1

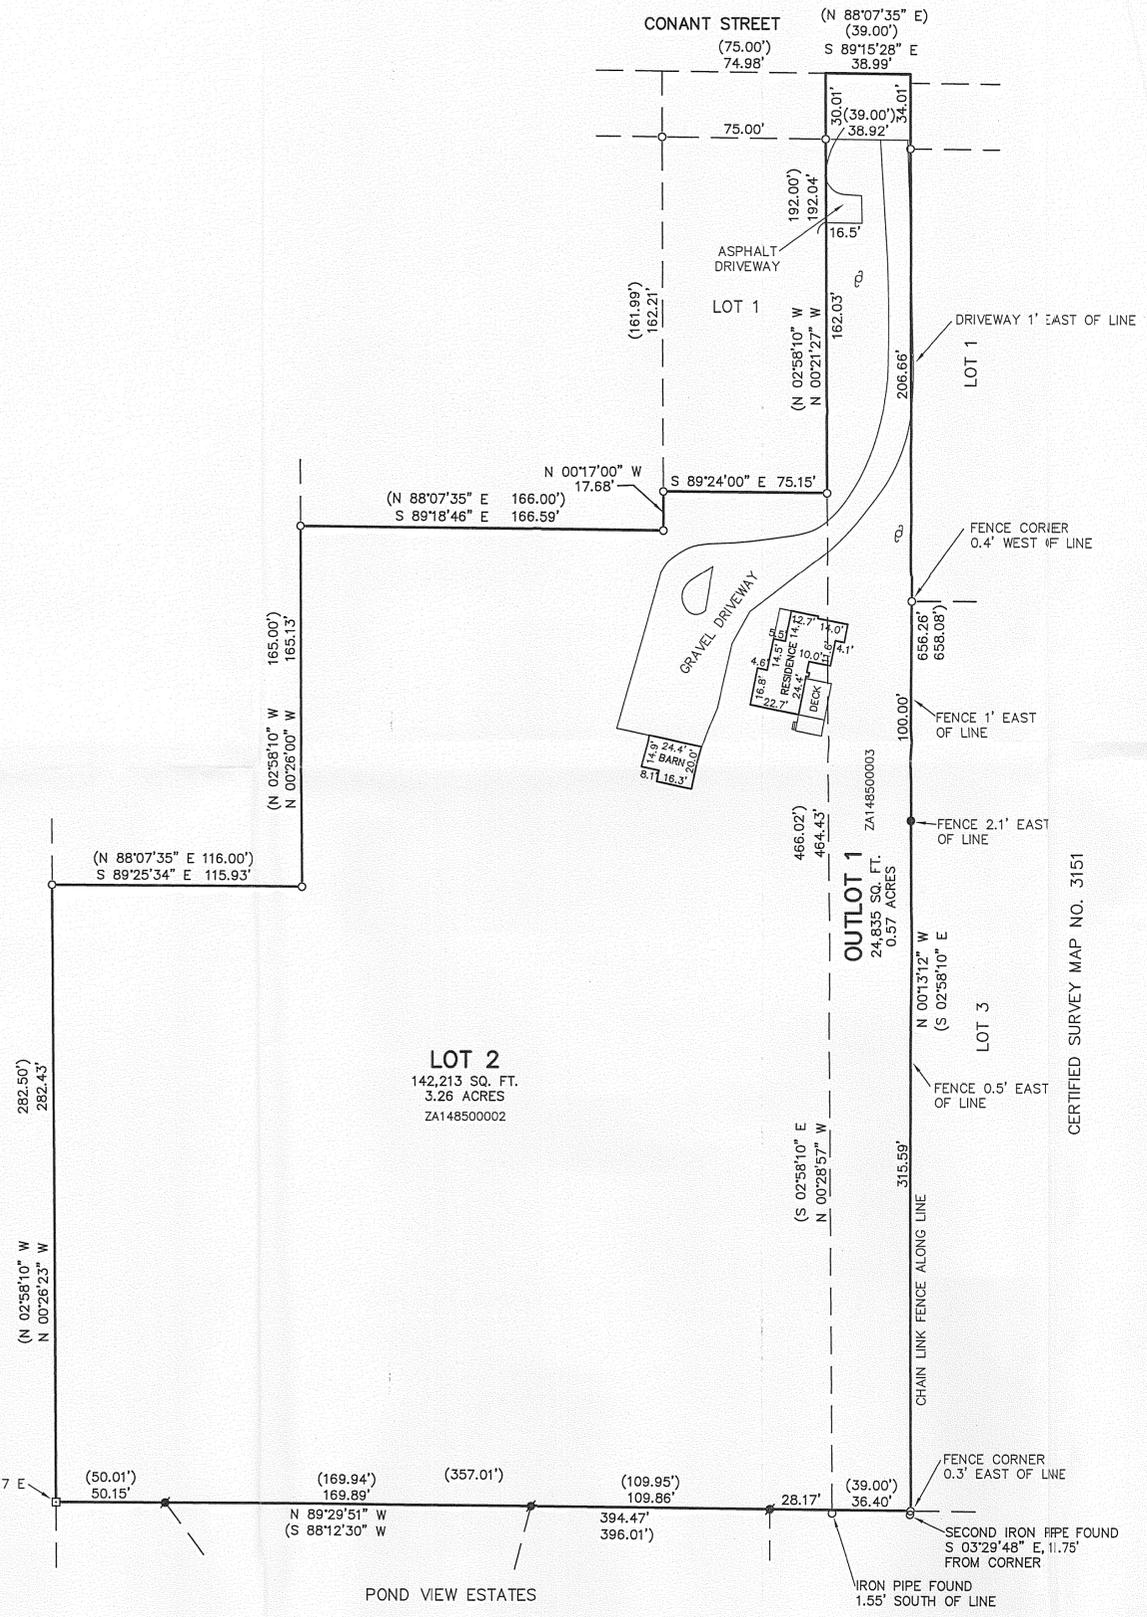


- LEGEND**
- - FOUND IRON PIPE STAKE
  - - FOUND IRON REBAR STAKE
  - - FOUND CONCRETE MONUMENT
  - - PLACED IRON REBAR STAKE
  - (XXX) - RECORDED AS
  - ⊕ - UTILITY POLE

PER RECORD C.S.M.  
NOTE: OUTLOT 1 IS RESERVED AS A PRIVATE ROAD IF LOT 2 IS REDIVIDED.



DATED: 5/28/2008  
*Peter S. Gordon*  
PETER S. GORDON

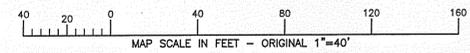

Z1485-2 Z1485-3

007-2605