

36 Mar. 31, '21

Survey for George
 Iron stake at N. W. Cor.
 Measured south on E. line
 Then 66' south for south line
 Measured south from iron
 360.4' (coincides with stake)
 Thence south 66' for S.
 With transit run line over
 at points in this line 143.5'
 Center St. for NW + N.E.
 Measured south from each
 60' south of above starting
 + 315.5' respectively and
 If stake at alley is set (an
 so alley stakes lot 1 should

Grout lot 1, Block 7, Crawford.

Block 6.


Center St. 360.4' for N. line Grove St.

Grove St. (1' south of N end concrete

stake at N. E. Cor. lot 2 Block 6.

at S. W. Cor. of lot 12 Block 6)

Block 6
 Crawford Ad.

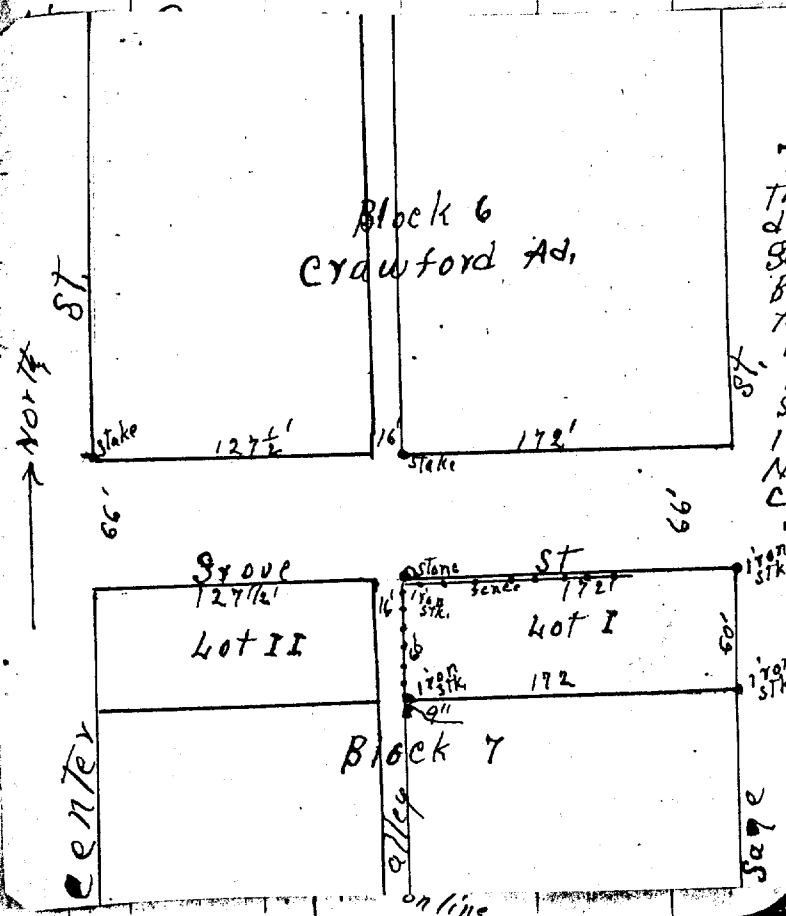

This is to certify
 that we have this
 day surveyed for
 Geo. Grout lot 1,
 Block 7, Crawford
 Ad. and have set
 iron stakes as
 indicated
 survey made from
 iron stakes at N.E. +
 N.W. Cors. lot 2 + S.W.
 Cors. lots 11 + 12, Block 6,
 4' 00' run in Block 6
 north + south
 J. S. Skeels
 Bessie Palmer
 Assistant
 Mar. 31, 1921
 Scale 100' to 1"

these 2 points and set iron stakes
and 315.5' east of ~~west~~^{east} line of
Cov's respectively of lot 1. Block 7.
point 60', and East from a point
point on E. line Center St. 143.5'
set iron stakes, for S.E. & S.W. Cors.
old stake) throwing .4' into street. Then
be .4' south and east stakes set south

