

69

Survey of Lot 8 Block 20
Original Geneva, Lyle Traver

April 3, 1928


Measured S. line Block 20, 368'
between walks. Measured across
Maxwell St. extension of S. line
of Block 20, app. 77 ft.
West walk of Block 20 was set out
1'. Allowing 1' for walk line
we measured east 60' and set
iron stk. 1' N. of S. walk.
Measured E. 60' more and set
iron stake for S.E. Cor. of Lot
8, 1' in from walk. This is app.
1' E. of S.W. Cor. of addition
to Geo. Smith's house.

Mr. Smith had been shown before
by a survey that his addition was
considerably over line. He claims
that Murray Howe former owner
of lot assented to setting of
addition and assumed it
to be online with division
fence.

Measured a cross line at S.
line Traver's house-garage
60' and made point, then 60'
farther east and found
fence on line

Set Transit on ^{1st} 60' point and
sighted on corresponding point
on S. line, inverted telescope
and measured N. & S. on this line
172' and made point set iron
stake for N.W. Cor. of Lot 8,
measured E. 60', lined in and
found as in previous survey
corner near center of tall post,
drove iron stake slanting so that
lower end rests app. on corner.
Sighted along a line of old
fence posts and had both
Traver & Smith sight over the
line of fence posts and both
saw that the line of posts would
cut into the upright part of
Smith's addition. So that
fence line agrees very close
with survey line.
Survey is correct assuming
the Block as built up.
It laid out as originally laid
out on paper and recorded
all lots in this Block would
move east & south.
J. G. S. C. 2. Bessie Palmer Asst

Lot 8 Blk 20 Orig Plat

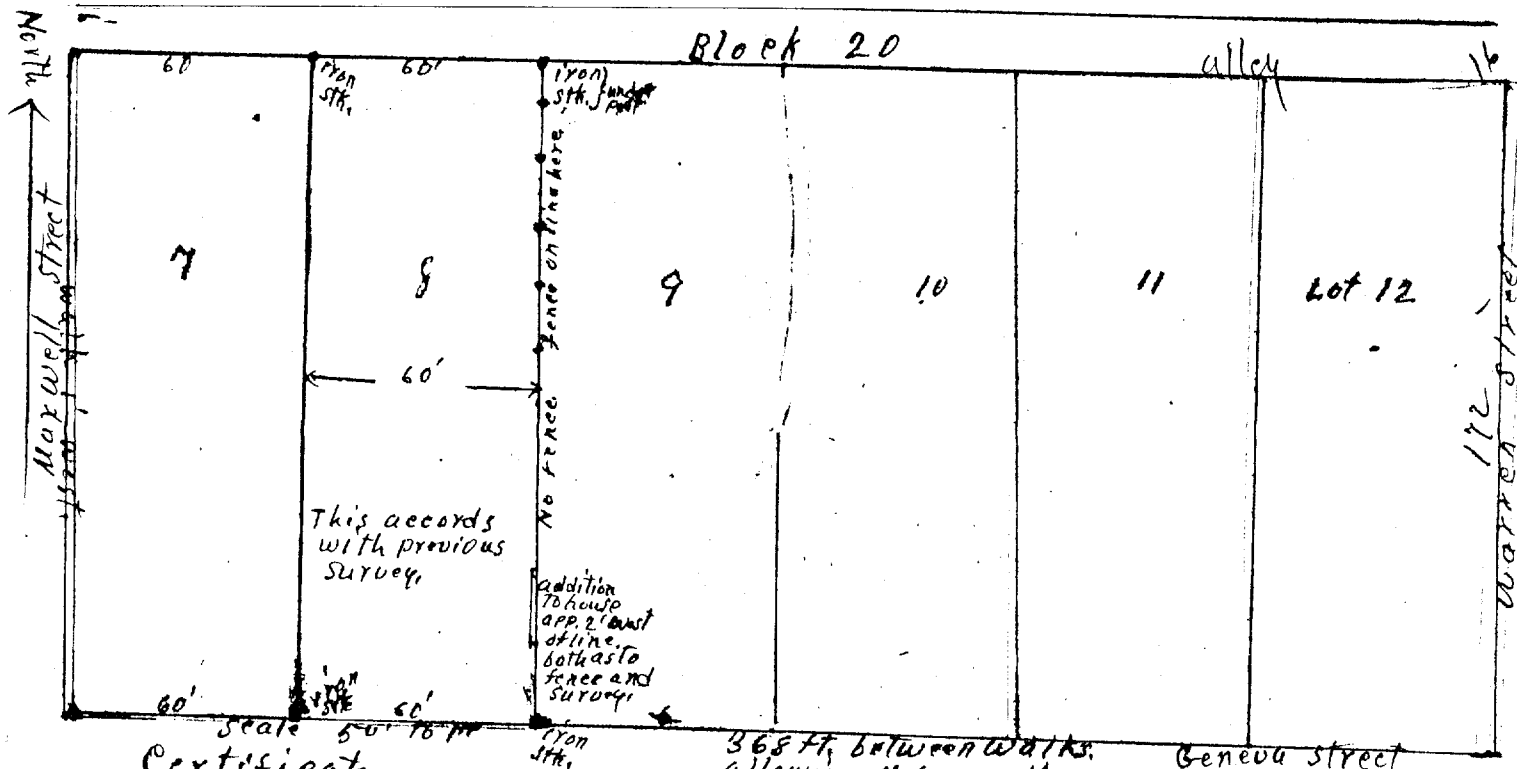

Certificate

This is to certify that by request of Lyle Trauer owner we surveyed and staked Lot 8 Block 20 as shown hereon, and allowing 1' for walks we find an overrun in the S. 1/2 of this Block of 6' which is taken up by lots 9, 10, 11 & 12. Both the fence line remaining and survey line show the west addition to house on Lot 8 to be at S.W. Cor. including eaves app. 2' west of line, Apr. 3, 1928, J. C. Skeels C. E., Bessie M. Palmer Asst

36.8 ft. between walks, allowing 1' for walks there is an overrun of 6' in the Block and all the overrun is occupied by lots 9, 10, 11 & 12. surveged as Geneva village is built up and not as recorded plat. Recorded plat would make this Block South & East

Hyperwritor Bldg

N. 14.