
PLAT OF SURVEY

PHONE 262-537-4874 262-537-4221

OF

Lot 37, EXCEPTING the south 29 feet of Lot 37, and the South Half of Lot 38 of STURWOOD ADDITION, located in the Northeast Quarter of Section 35, Town 2 North, Range 17 East, City of Lake Geneva, Walworth County, Wisconsin.

PARCEL IDENTIFICATION NO: ZST 00036

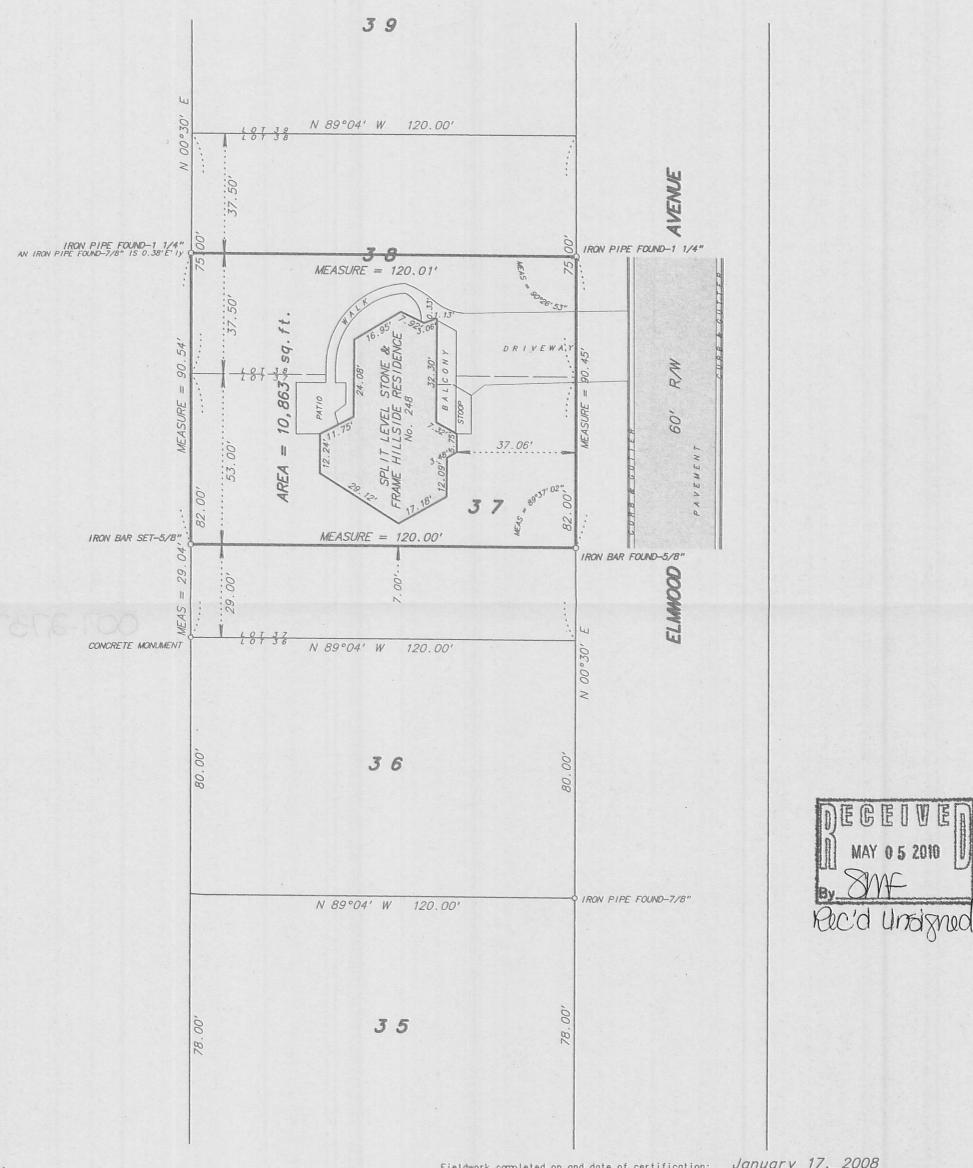

Coldwell Banker ORDERED BY L. Rodriguez / Primus Realty JOB NO. 08006

ZST-36

Fieldwork completed on and date of certification: January 17, 2008

I hereby certify that I have surveyed the above described property and the above plat is a true representation thereof and shows the size and location of the property, its exterior boundaries, the location and dimensions of all visible structures thereon, boundary fences, apparent easements and roadways and visible encroachments, if any.

This survey is made for the exclusive use of the present owners of the property, and also those who purchase, mortgage or guarantee the title thereto within ONE YEAR from the date hereof.

Dated at Bassett, Wisconsin this _____ day of ____

Mark A. Bolender