

FARRIS, HANSEN & ASSOCIATES, INC.


ENGINEERING — ARCHITECTURE — SURVEYING
7 RIDGWAY COURT — P.O. BOX 437 — ELKHORN, WISCONSIN 53121
PHONE: (262) 723-2098 FAX: (262) 723-5886

PLAT OF SURVEY LOT 11 LAKE GENEVA BUSINESS PARK

Lot 11, excepting therefrom the Southwesterly 36.68 feet, of Lake Geneva Business Park, located in the Southeast 1/4 of the Northwest 1/4, the Southwest 1/4 of the Northeast 1/4, the Northwest 1/4 of the Southeast 1/4, the Northeast 1/4 of the Southeast 1/4 and the Southwest 1/4 of the Southeast 1/4 of Section 31, T2N, R18E, City of Lake Geneva, Walworth County, Wisconsin.

Tax Key No: ZLGIBP00011

BEARINGS REFERENCED TO
ORIGINAL SUBDIVISION PLAT

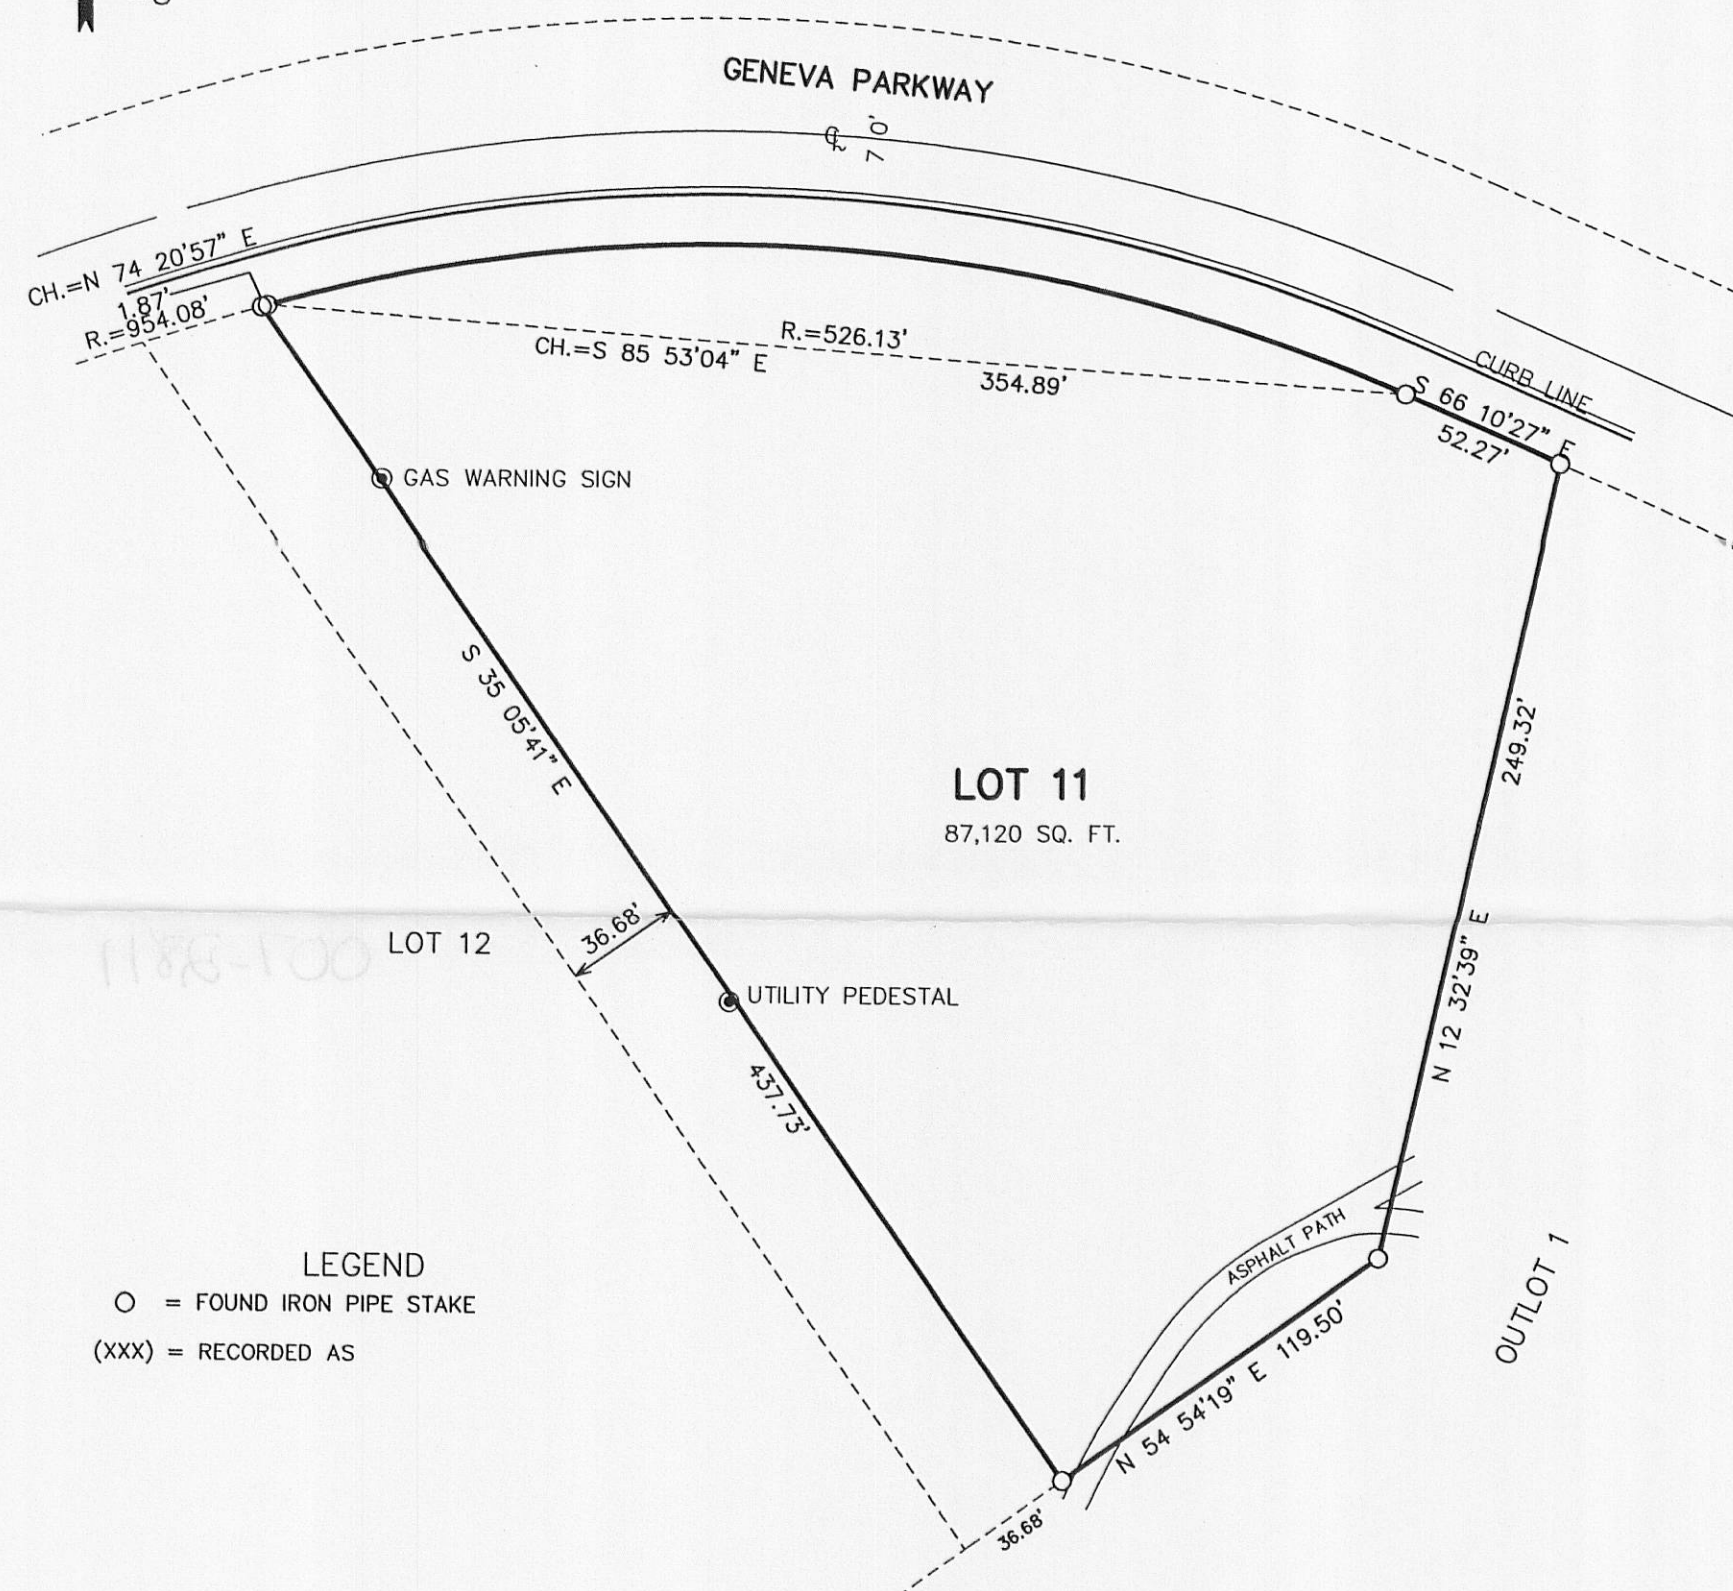

LEGEND

- = FOUND IRON PIPE STAKE
- (XXX) = RECORDED AS


100 50 0 50 100 150 200
MAP SCALE IN FEET ORIGINAL 1" = 60'

NOTE: COPIES OF THIS MAP TO WHICH THE FOLLOWING CERTIFICATE WILL APPLY SHOW SURVEYOR'S ORIGINAL SEAL AND SIGNATURE IN RED INK. COPIES BY ANY OTHER MEANS MAY HAVE ALTERATIONS WHICH DO NOT REPRESENT THE SURVEYOR'S WORK PRODUCT.

I HEREBY CERTIFY THAT THE ABOVE DESCRIBED PROPERTY HAS BEEN SURVEYED UNDER MY DIRECTION AND THAT THE ABOVE MAP IS A TRUE REPRESENTATION THEREOF AND SHOWS THE SIZE AND LOCATION OF THE PROPERTY, ITS EXTERIOR BOUNDARIES, THE LOCATION OF ALL VISIBLE STRUCTURES, AND DIMENSIONS OF ALL PRINCIPLE BUILDINGS THEREON, BOUNDARY FENCES, APPARENT EASEMENTS, ROADWAYS, AND VISIBLE ENCROACHMENTS, IF ANY. THIS SURVEY IS MADE FOR THE USE OF THE PRESENT OWNERS OF THE PROPERTY, AND ALSO THOSE WHO PURCHASE, MORTGAGE, OR GUARANTEE THE TITLE THERETO WITHIN ONE YEAR FROM THE DATE HEREOF.

DATED: MAY 2, 2011

Peter S. Gordon
PETER S. GORDON R.L.S. 2101

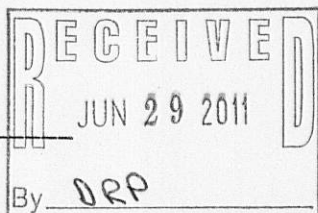

PROJECT: 8332
DATE: 05-02-2011
SHEET 1 OF 1

MAY 02 2011

ZLGIBP-11

007-2811