


HAROLD H. KOLB


REGISTERED PROFESSIONAL LAND SURVEYOR
LAKE GENEVA, WISCONSIN

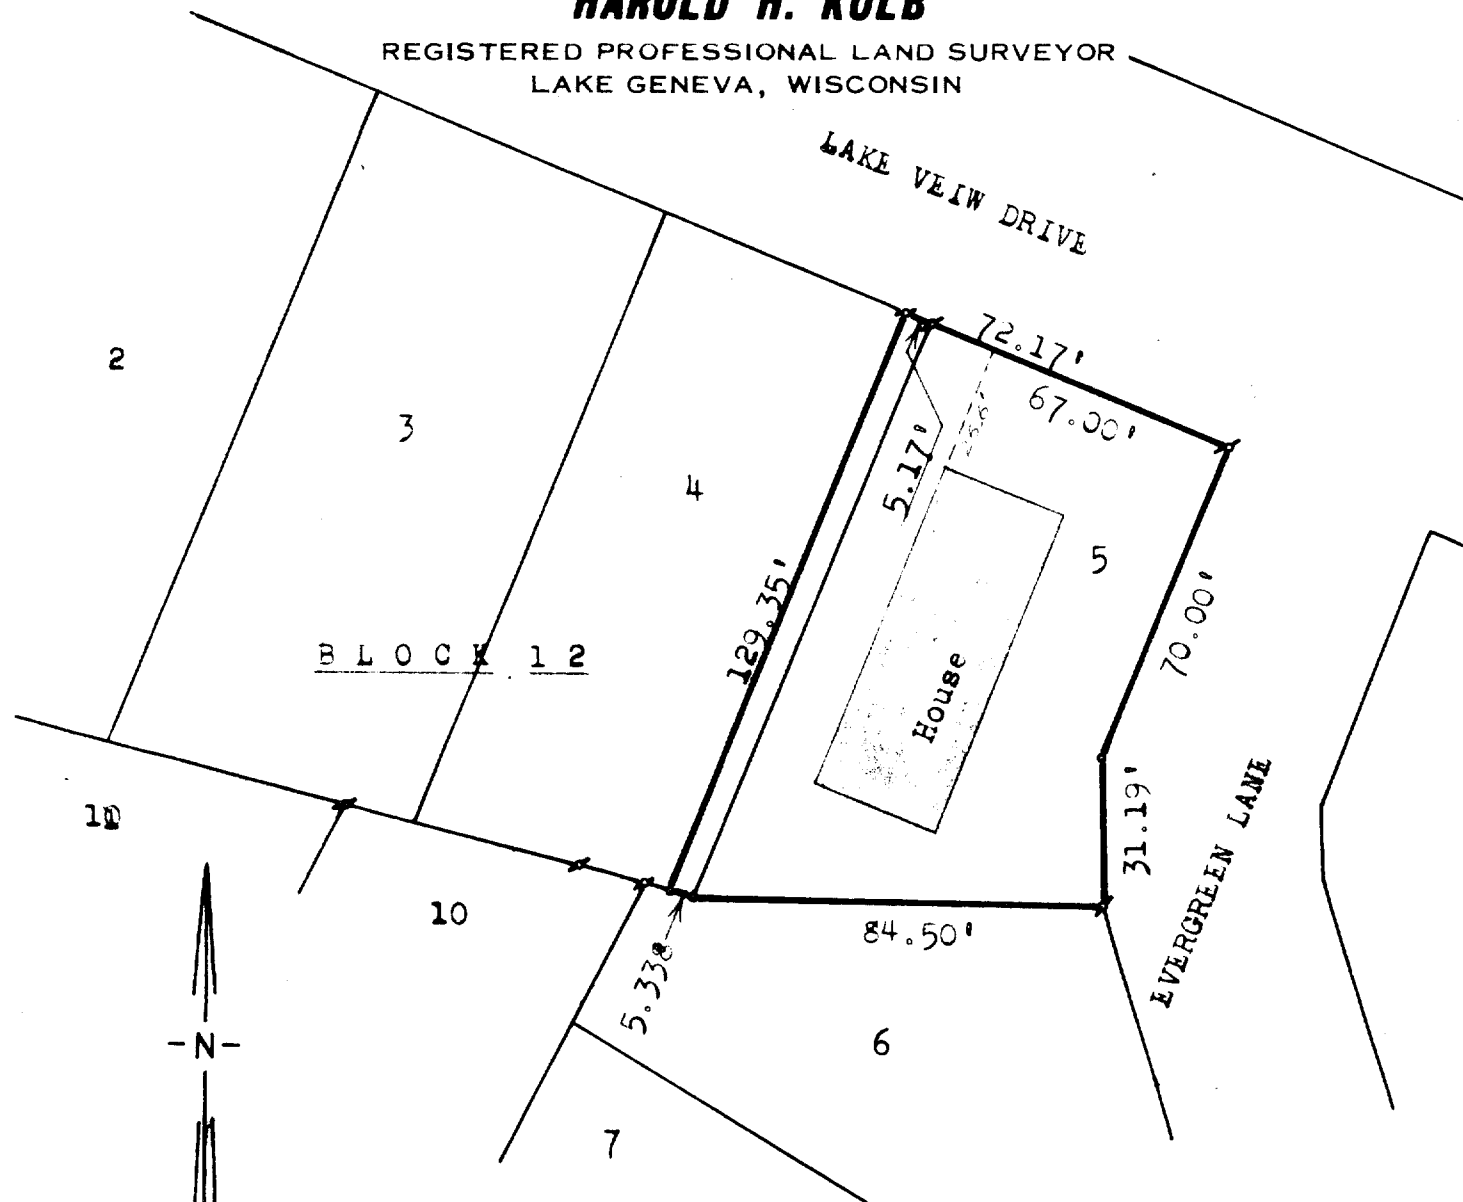

SCALE: 1" = 40'

LEGEND

- IRON PIPE FOUND
- IRON PIPE PLACED
- — CONCRETE MONUMENT
- x — SPIKE

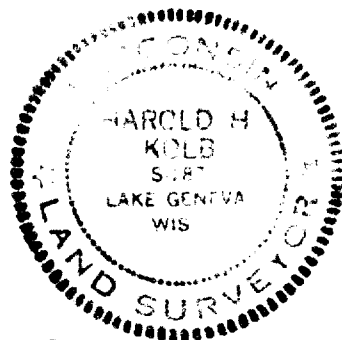

Plat of Survey of

Lot 5 and the Southeasterly 5'2" of Lot 4,
Lake Geneva Manor, a subdivision located
in the City of Lake Geneva, Walworth
County, Wisconsin.

I, HAROLD H. KOLB, DO HEREBY CERTIFY THAT I HAVE
SURVEYED THE PROPERTY HEREON DESCRIBED ACCORDING
TO THE OFFICIAL RECORDS, AND THAT THE PLAT HEREON
IS A CORRECT REPRESENTATION OF THE LOT LINES.

Harold H. Kolb

HAROLD H. KOLB

WISCONSIN REGISTERED LAND SURVEYOR, S-187

DATE January 14, 1965

RECEIVED: JAN 17 1965

NOTED: ALL

ZLM-5

117-288K