

FARRIS, HANSEN & ASSOC. INC.



7 RIDGWAY COURT- P.O. BOX 437
ELKHORN, WISCONSIN 53121
PHONE (262) 723-2098
FAX (262) 723-5886

ORDERED BY: BASSO BUILDERS
405 SKYLINE DRIVE
LAKE GENEVA, WI. 53147

PLAT OF SURVEY

LOT 1 CSM 4049
REC. AS DOC. 709143

LOCATED IN PART OF THE NE 1/4 OF THE NE 1/4
OF SECTION 1, TOWN 1 NORTH, RANGE 17 EAST,
CITY OF LAKE GENEVA, WALWORTH COUNTY, WISCONSIN

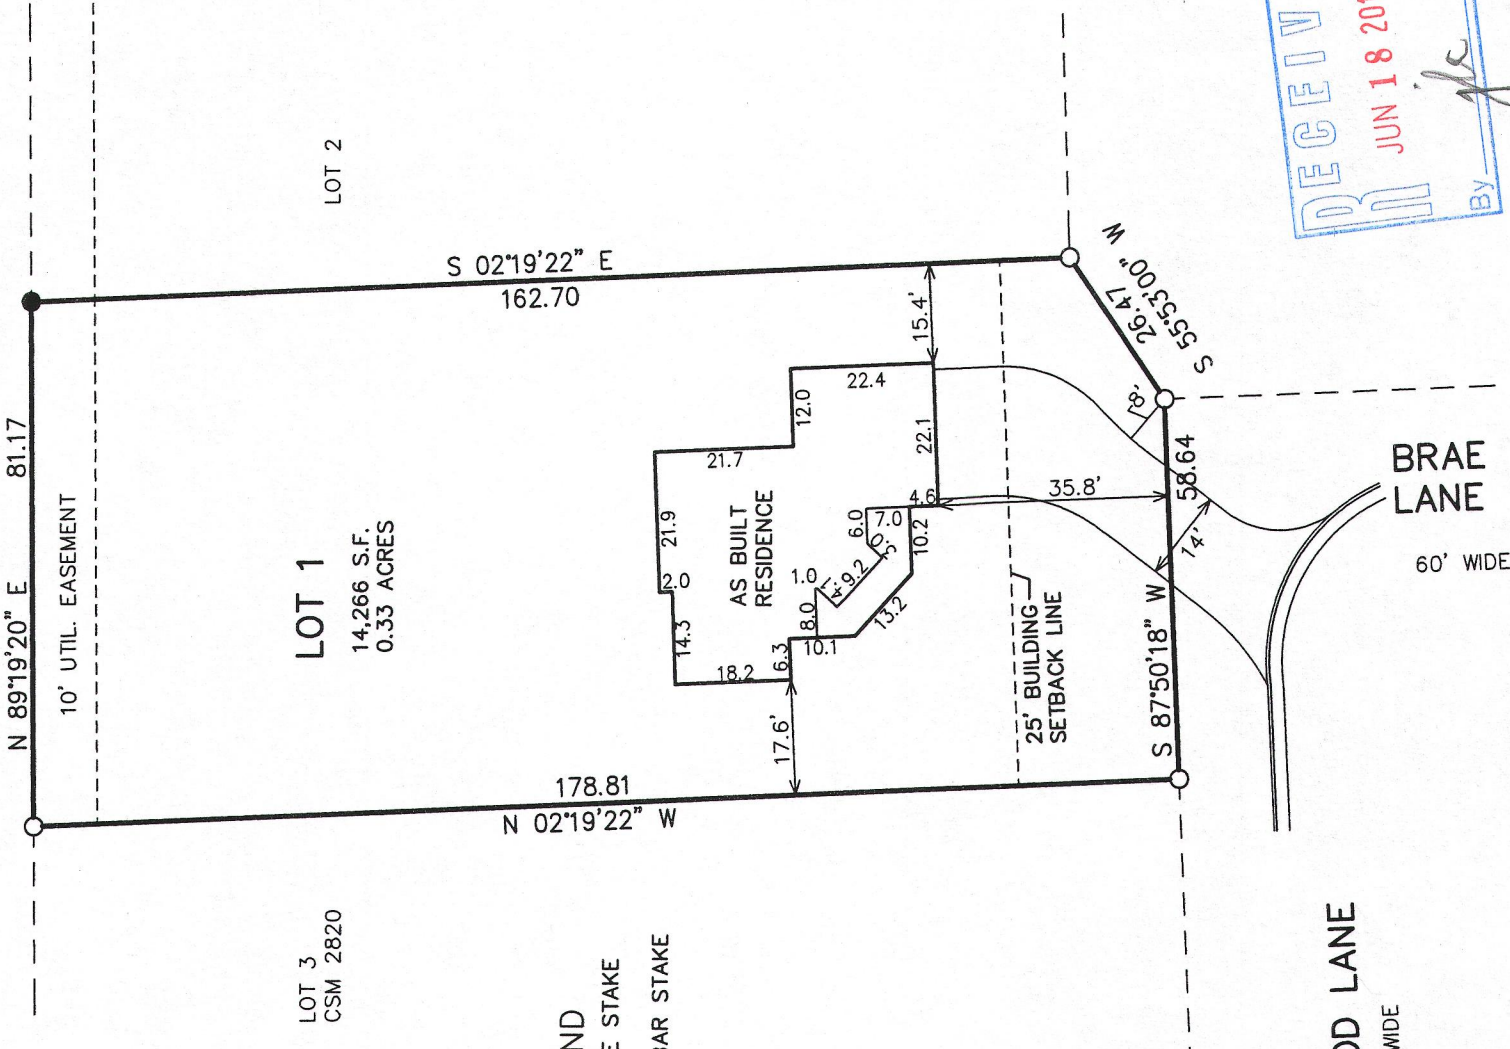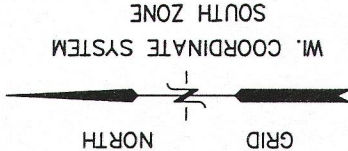

- LEGEND
- = FOUND IRON PIPE STAKE
 - = FOUND IRON REBAR STAKE
 - (XXX) = RECORDED AS

NOTE: COPIES OF THIS MAP TO WHICH THE FOLLOWING CERTIFICATE WILL APPLY SHOW SURVEYOR'S ORIGINAL SEAL AND SIGNATURE IN RED INK. COPIES BY ANY OTHER MEANS MAY HAVE ALTERATIONS WHICH DO NOT REPRESENT THE SURVEYOR'S WORK PRODUCT.

I HEREBY CERTIFY THAT THE ABOVE DESCRIBED PROPERTY HAS BEEN SURVEYED UNDER MY DIRECTION AND THAT THE ABOVE MAP IS A TRUE REPRESENTATION THEREOF AND SHOWS THE SIZE AND LOCATION OF THE PROPERTY AND ITS EXTERIOR BOUNDARIES. THIS SURVEY IS MADE FOR THE USE OF THE PRESENT OWNERS OF THE PROPERTY, AND ALSO THOSE WHO PURCHASE, MORTGAGE, OR GUARANTEE THE TITLE THERETO WITHIN ONE YEAR FROM THE DATE HEREOF.


DATED: MAY 10, 2007

REVISED 02-08-2013
TO SHOW REVISED RESIDENCE & DRIVE LOCATION

REVISED 05-17-2013
TO SHOW SIZE & LOCATION OF
AS BUILT RESIDENCE

K. Belongia
KRISTIN J. BELONGIA R.L.S. 2943

THIS INSTRUMENT DRAFTED
BY PETER S. GORDON
PROJECT NO. 7298.1
DATED: 01-04-2013
SHEET 1 OF 1 SHEETS

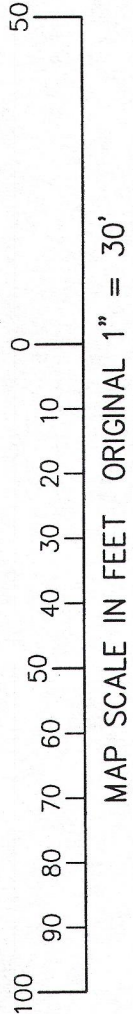

2A4049-1 007-2941