


PLAT OF SURVEY

PATHFINDER SURVEYING INC.
(formerly)
J.K. SURVEYING INC.
P.O. BOX 322
LAKE GENEVA, WI. 53147
WWW.PATHFINDERSURVEYING.NET
262-248-8303

-OF-

LOT 8 GENEVA WOODS, A SUBDIVISION LOCATED IN THE NW 1/4 OF THE NE 1/4 AND THE NE 1/4 OF THE NE 1/4 OF SECTION 1, TOWN 1 NORTH, RANGE 17 EAST, CITY OF LAKE GENEVA, WALWORTH COUNTY, WISCONSIN.

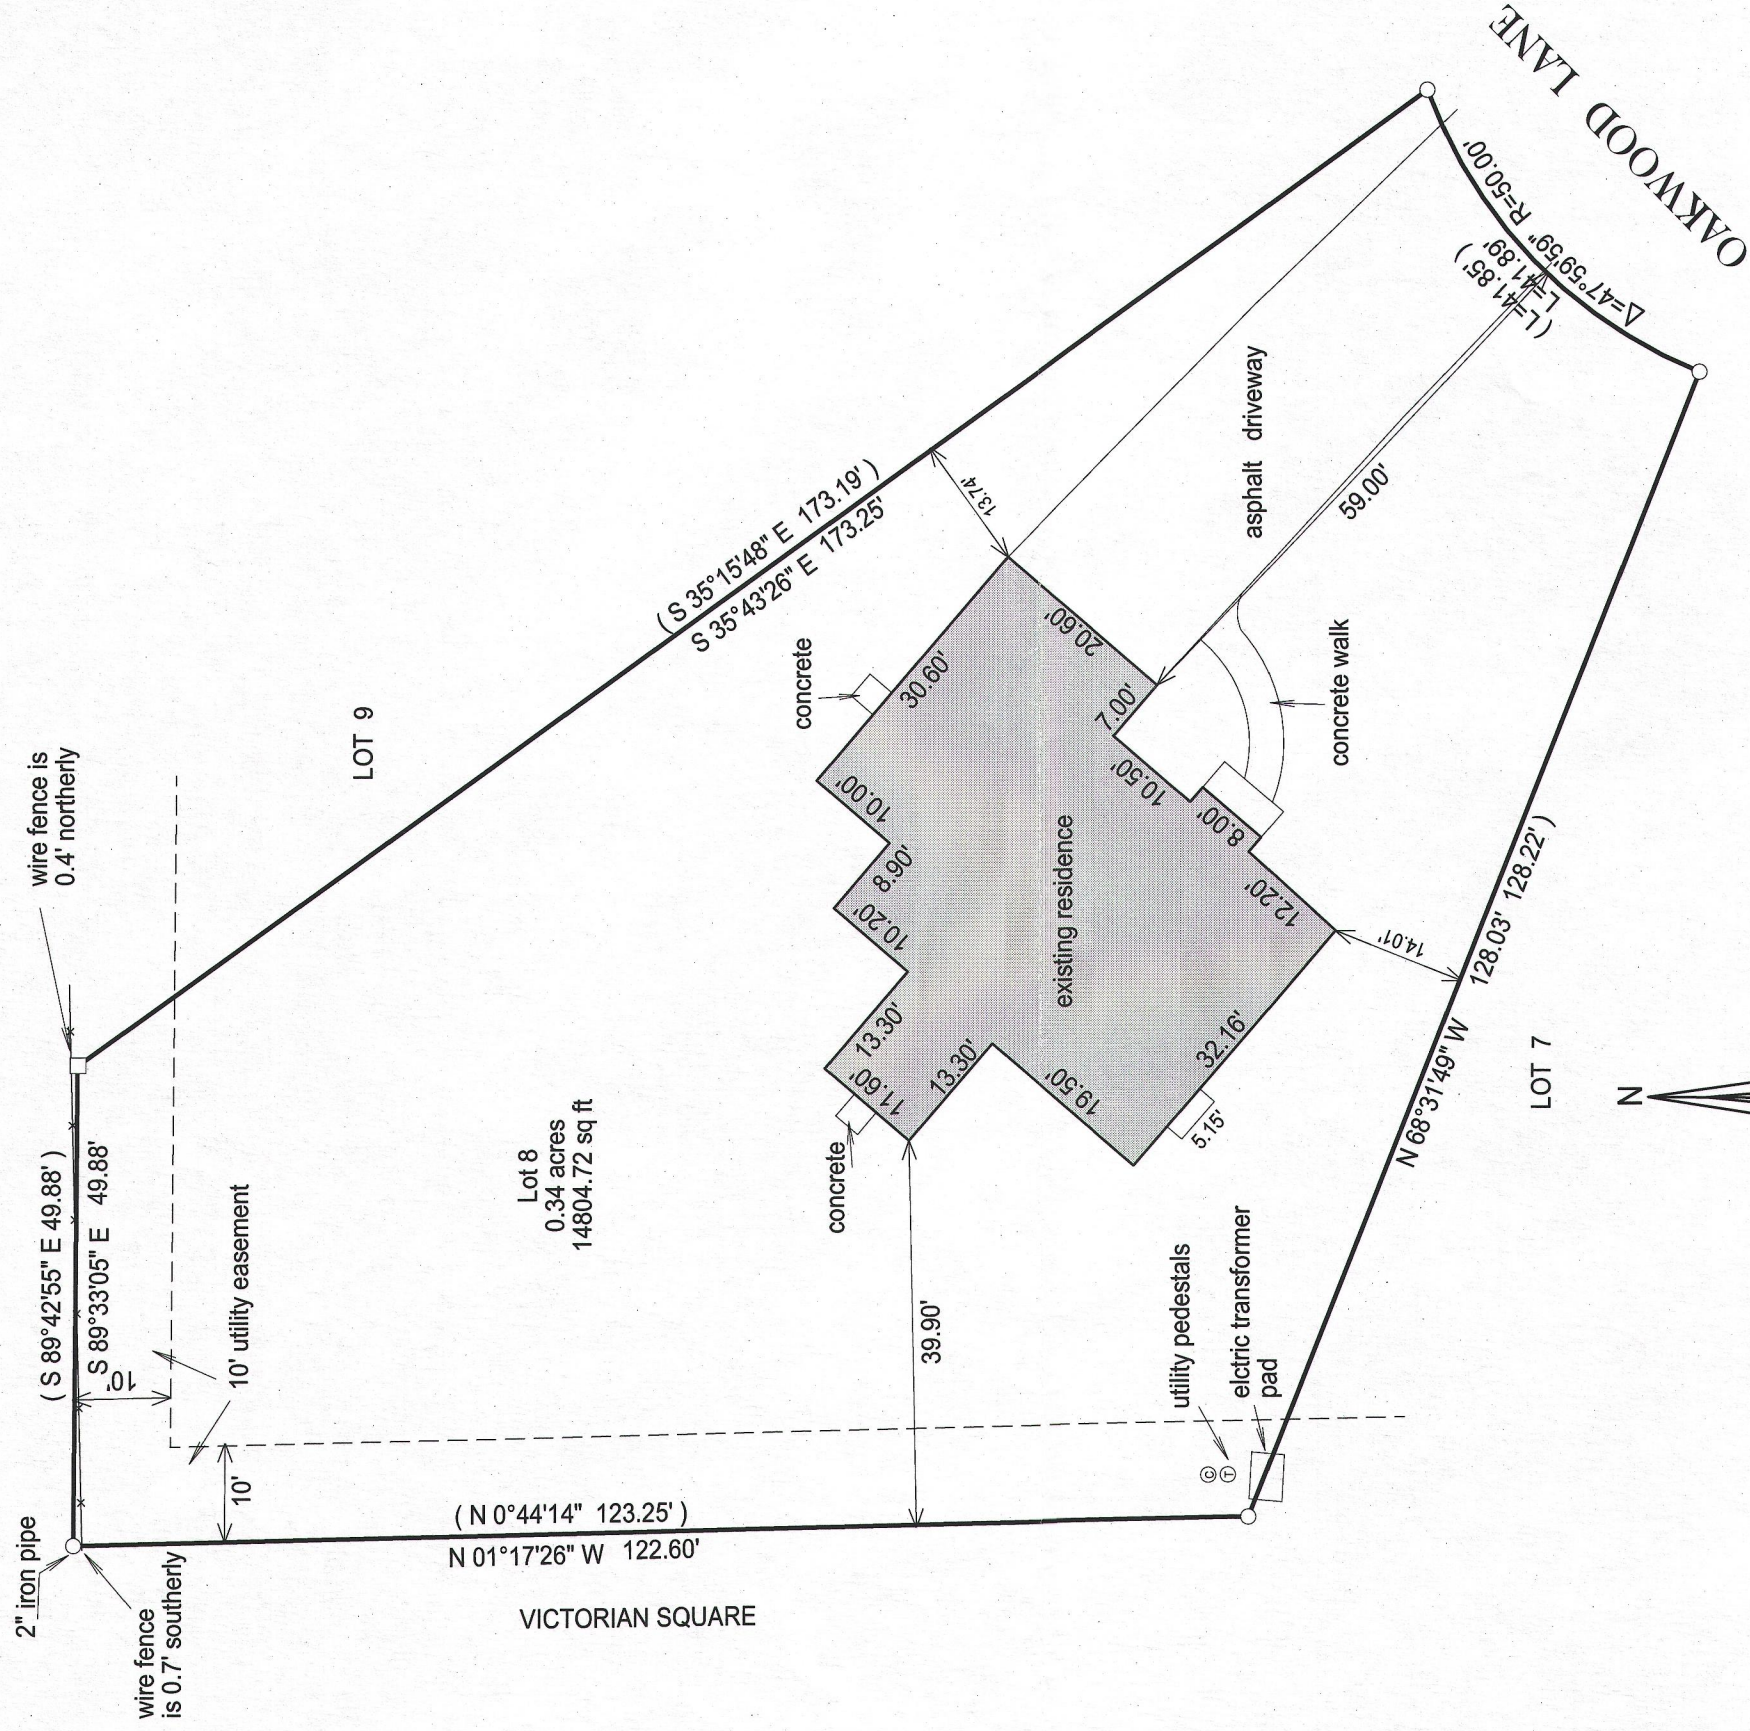

() = recorded as


- ☐ = found iron bar
- ☐ = found iron pipe
- ☒ = set iron pipe
- ☐ = set iron bar

SCALE 1" = 20'

JOB # 13-50

TAX ID #

ZGW 00008

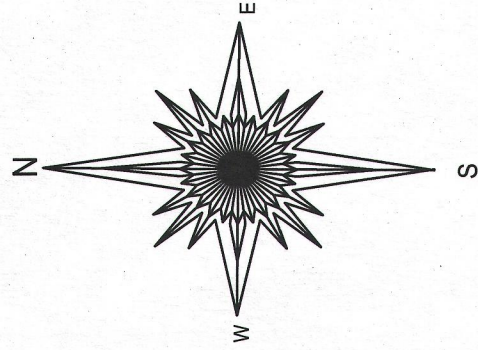

BASIS OF BEARING OF THIS PLAT: THE SOUTH LINE OF LOT 8 WAS ASSUMED TO BEAR N68°31'49" W AS SHOWN ON THE RECORD PLAT OF GENEVA WOODS.

I hereby certify that I have surveyed the above-described property and the above map is a true representation thereof and shows the size and location of the property, its exterior boundaries, the location and dimensions of all structures thereon, fences, apparent easements and roadways and visible encroachments if any.

This survey is made for the present owners of the property, and those who purchase, mortgage, or guarantee the title thereto, within one year from the date hereof.

DATED THIS 8TH DAY OF MAY, 2013.



JEFFREY L KIMPS S - 2436
Wisconsin Registered Land Surveyor
(original if signed in red)

007-2956