


- OF -

GRAVEL ROAD

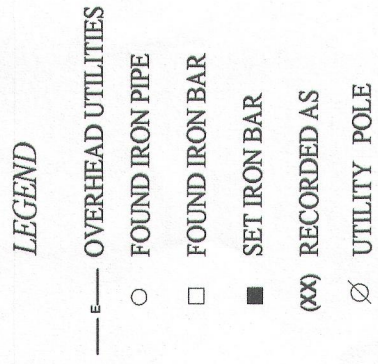

I have surveyed the above-described property and the above map is a true representation thereof and shows the size and location of the property, its exterior boundaries, the location and dimensions of all structures thereon, fences, apparent easements and roadways and visible encroachments, if any.

This survey is made for the exclusive use of the present owners of the property, and also those who purchase, mortgage, or insure the title thereto within one (1) year from date hereof; and as to them I warrant the accuracy of said survey map.


JOHN KROTT S - 2258
Wisconsin Registered Land Surveyor
(original if signed in red)

LEGEND

— E — OVERHEAD UTILITIES

○ FOUND IRON PIPE

□ FOUND IRON BAR

■ SET IRON BAR

(xx) RECORDED AS

∅ UTILITY POLE

JOB # 01-522UD2013
TAX ID # ZOP 003891

TAX ID # ZOP 00389F, 00389E & 00389L

200-389 F
200-389 F

202-389L

007-2978