


HAROLD H. KOLB


REGISTERED PROFESSIONAL LAND SURVEYOR
LAKE GENEVA, WISCONSIN

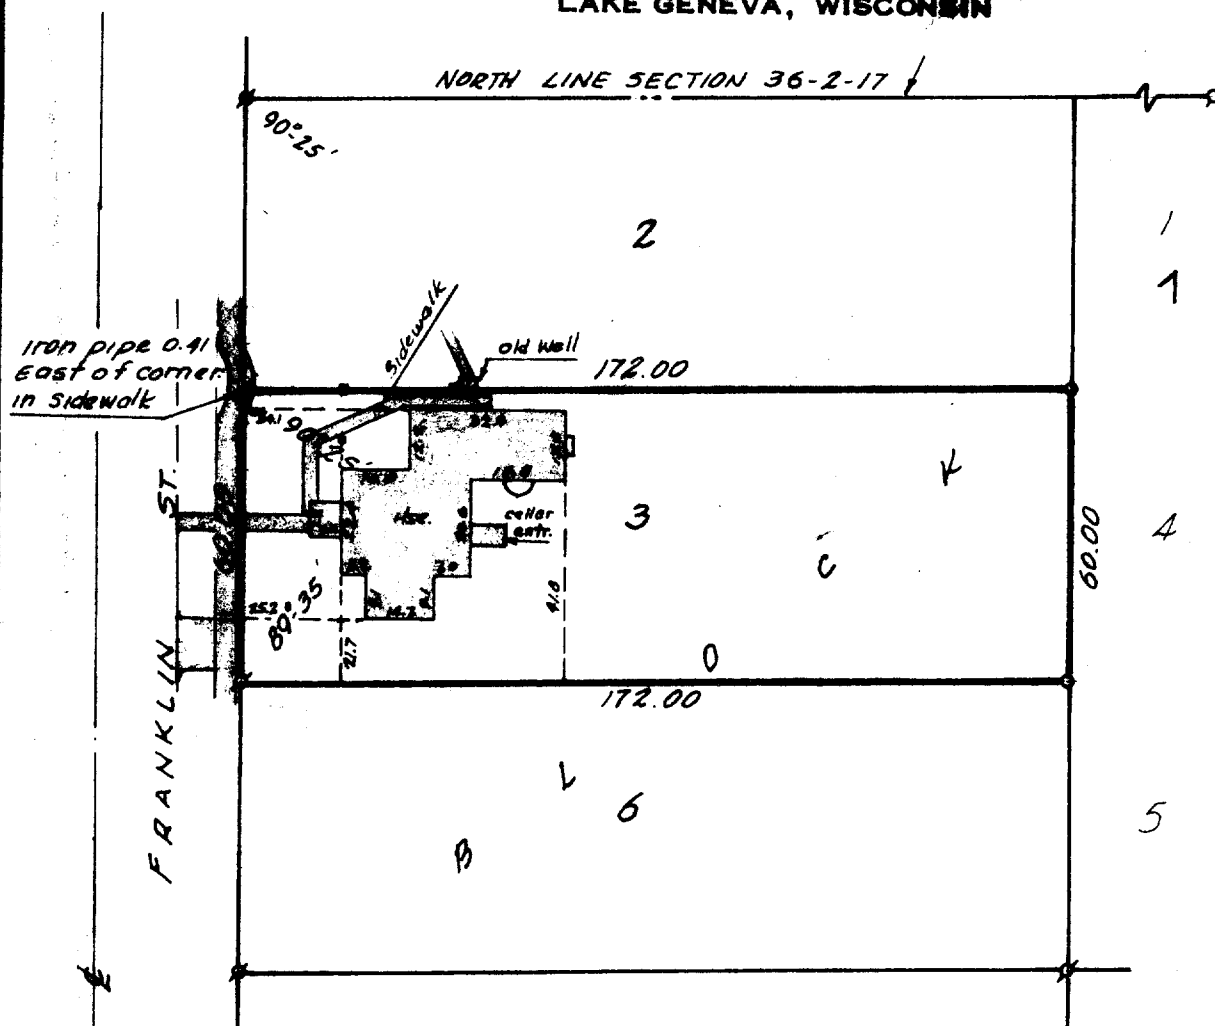

N

LEGEND

- - IRON PIPE FOUND
 - - IRON PIPE PLACED
 - - CONCRETE MONUMENT
 - ✕ - SPIKE
- SCALE - 1" = 40'

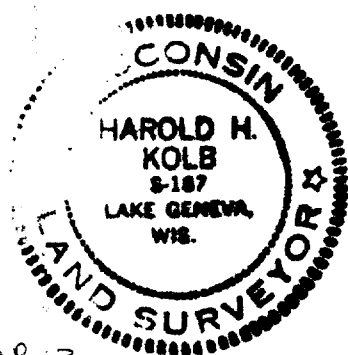

PLAT OF SURVEY OF
Lot 3, David O. Marsh Subdivision of Block 7,
City of Lake Geneva, Walworth County, Wis.

I, HAROLD H. KOLB, DO HEREBY CERTIFY THAT I HAVE
SURVEYED THE PROPERTY HEREON DESCRIBED ACCORDING
TO THE OFFICIAL RECORDS, AND THAT THE PLAT HEREON
IS A CORRECT REPRESENTATION OF THE LOT LINES and the
principle lines of the buildings thereon.

Harold H. Kolb

HAROLD H. KOLB

WISCONSIN REGISTERED LAND SURVEYOR, 8-187

DATE OCT. 27, 1969

REVISED: January 12, 1970 *H. Kolb*