

FARRIS, HANSEN & ASSOC. INC.


7 RIDGWAY COURT- P.O. BOX 437
ELKHORN, WISCONSIN 53121
PHONE (262) 723-2098
FAX (262) 723-5886

PLAT OF SURVEY
THE NORTH 112 FEET OF LOT 6, BLOCK 9
ORIGINAL PLAT, CITY OF LAKE GENEVA
LOCATED IN THE NW 1/4 OF THE NW 1/4 SEC. 36
TOWN 2 NORTH, RANGE 17 EAST, CITY OF LAKE GENEVA
WALWORTH COUNTY, WISCONSIN

The North 112 feet of Lot 6 in Block 9 of the Village of Geneva, now City of Lake Geneva, Walworth County, Wisconsin.

Fax Key No: ZOP 00061A

DODGE STREET (80' WIDE)

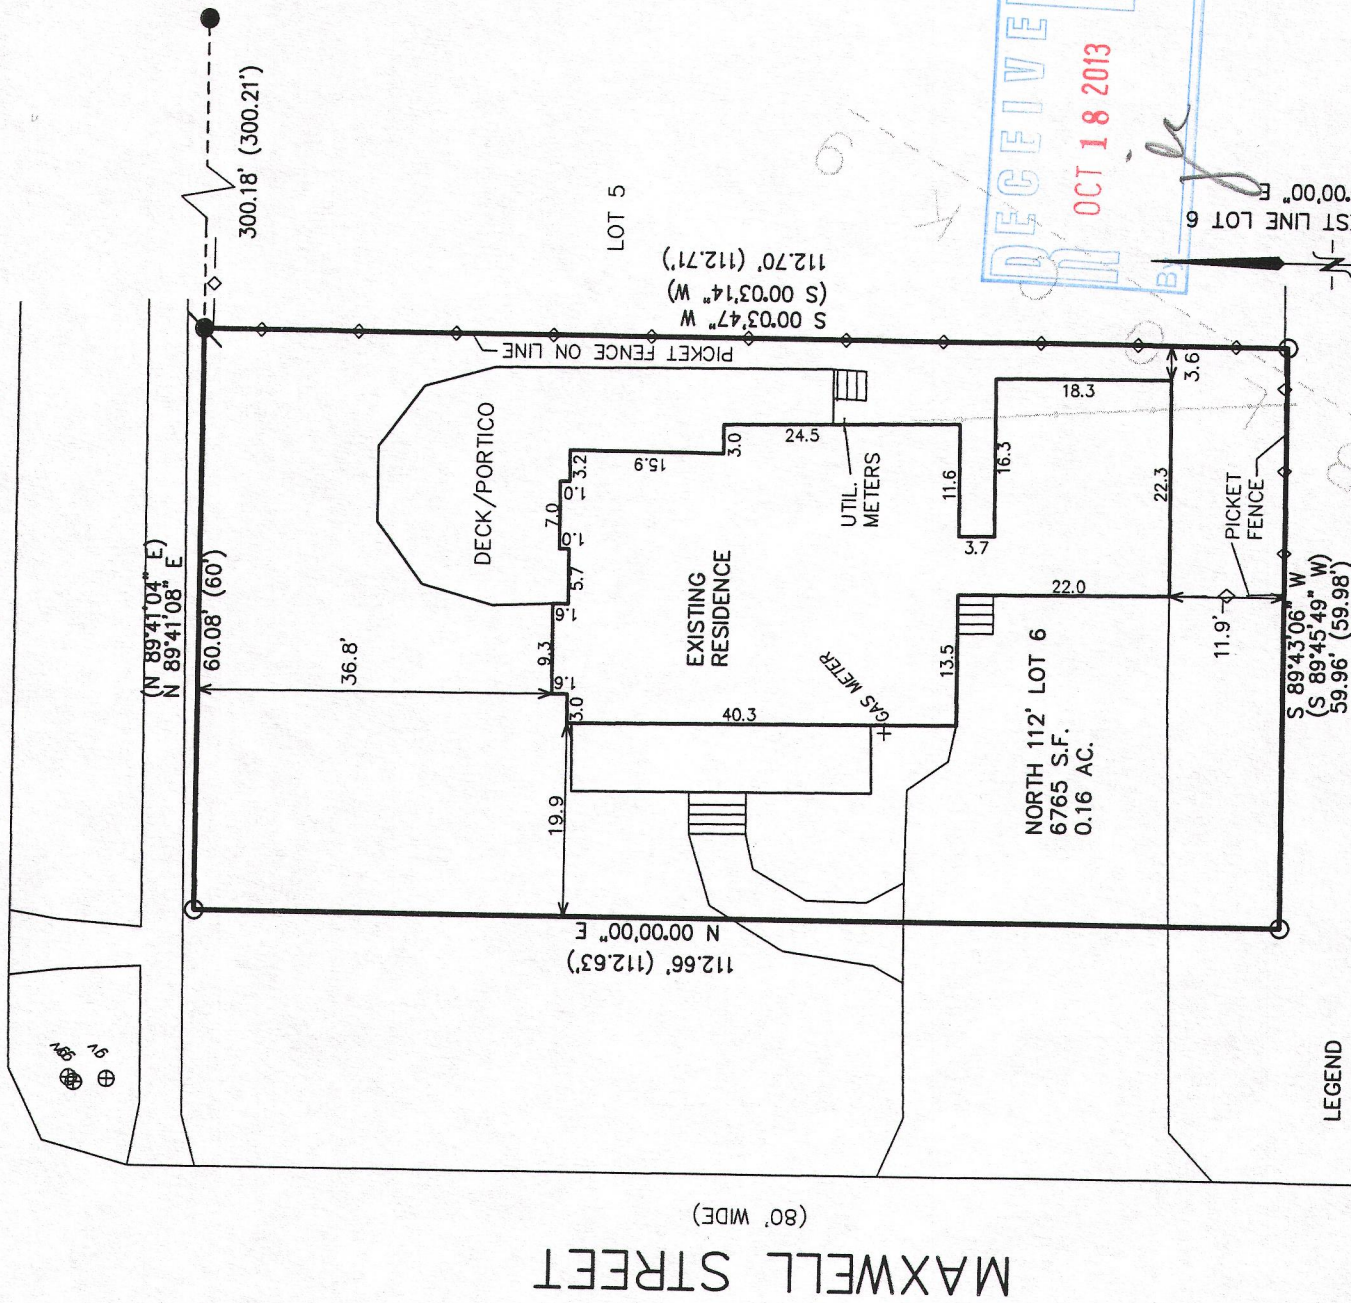

LEGEND

- = FOUND IRON PIPE STAKE
- = FOUND IRON REBAR STAKE
- ⦿ = SET IRON REBAR STAKE
- (xxx) = RECORDED AS

ORDERED BY: THE RAULAND AGENCY
PO BOX 159
WALWORTH, WI. 53184

NOTE: COPIES OF THIS MAP TO WHICH THE FOLLOWING CERTIFICATE WILL APPLY SHOW THE SURVEYOR'S ORIGINAL SEAL AND SIGNATURE IN RED INK. COPIES BY ANY OTHER MEANS MAY HAVE ALTERATIONS WHICH DO NOT REPRESENT THE SURVEYOR'S WORK PRODUCT.

I HEREBY CERTIFY THAT THE ABOVE DESCRIBED PROPERTY HAS BEEN SURVEYED UNDER MY DIRECTION AND THAT THE ABOVE MAP IS A TRUE REPRESENTATION THEREOF AND SHOWS THE SIZE AND LOCATION OF THE PROPERTY, ITS EXTERIOR BOUNDARIES, THE LOCATION OF ALL VISIBLE STRUCTURES, AND DIMENSIONS OF ALL PRINCIPLE BUILDINGS THEREON, BOUNDARY FENCES, APPARENT EASEMENTS, ROADWAYS, AND VISIBLE ENCROACHMENTS, IF ANY. THIS SURVEY IS MADE FOR THE USE OF THE PRESENT OWNERS OF THE PROPERTY, AND ALSO THOSE WHO PURCHASE, MORTGAGE, OR GUARANTEE THE TITLE THERETO WITHIN ONE YEAR FROM THE DATE HEREOF.

DATED: SEPTEMBER 10, 2013

Peter S. Gordon


PETER S. GORDON

PROJECT NO. 8883

DATED: 09-09-2013

SHEET 1 OF 1 SHEETS

NOTE:
AN EASEMENT RECORDED IN VOL. 466 OF DEEDS, ON PAGE 483
ALLOWS FOR A SANITARY LATERAL RUNNING SOUTH TO THE
ALLEY IN BLOCK 9 TO EXIST AND BE MAINTAINED OVER THE
SOUTH 60 FEET OF LOT 6. NO MORE SPECIFIC LOCATION OR
WIDTH IS GIVEN.

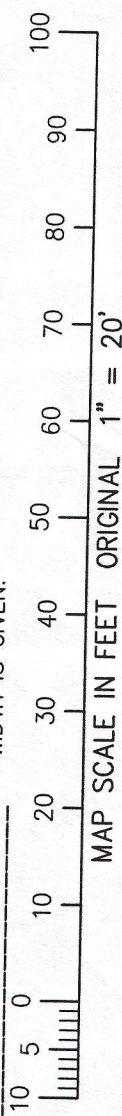

SEP 16 2013

ZOP-64A

007-2982

