


LOT 1 OF GENEVA WOODS, LOCATED IN THE
NORTHWEST 1/4 OF THE NORTHEAST 1/4 AND
THE NORTHEAST 1/4 OF THE NORTHEAST 1/4
OF SECTION 1, TOWN 1 NORTH, RANGE 17 EAST,
CITY OF LAKE GENEVA, WALWORTH COUNTY,
WISCONSIN.

ORDERED BY: STACEY SCHULTZ
KEEFE REAL ESTATE
751 GENEVA PARKWAY
LAKE GENEVA, WI 53147

OAKWOOD LANE

(60' WIDE)

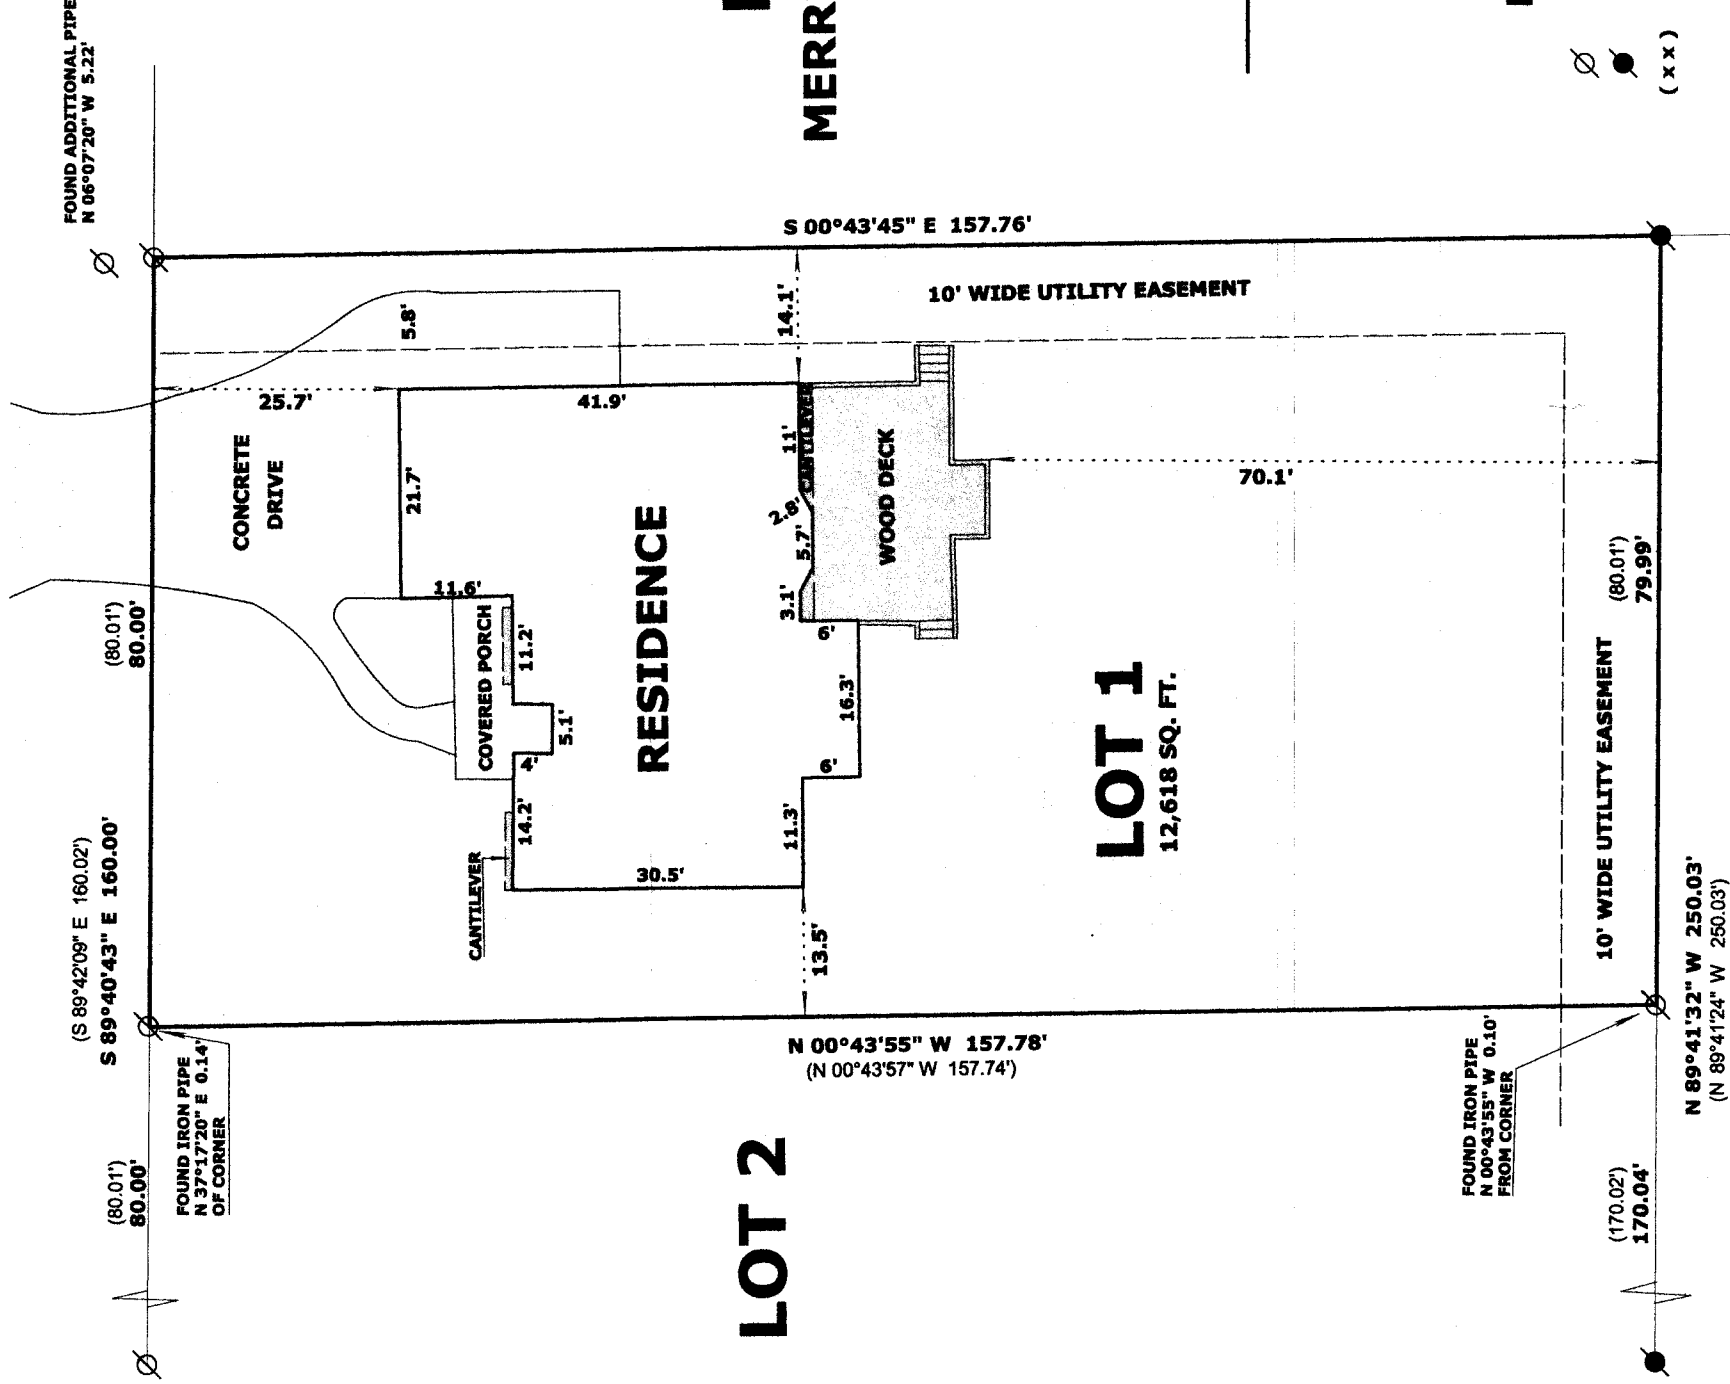


LEGEND

- Ø FOUND IRON PIPE 1 1/4"
● FOUND IRON PIPE 2"
(x x) RECORDED AS DIMENSION

SCALE: 1 INCH = 20 FEET

"I hereby certify that the above described property has been surveyed by me or under my direction and that the above map is a true representation thereof and shows the size and location of the property, its exterior boundaries, the location of all visible structures and dimensions of all principal buildings thereon, boundary fences, apparent easements, roadways and visible encroachments, if any."
"This survey is made for the use of the present owners of the property, and also those who purchase, mortgage, or guarantee the title thereto within one year from date hereof."

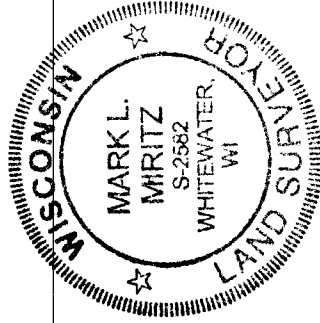

DEC 1 2 2013

Mark L. Miritz
MARK L. MIRITZ
WISCONSIN REGISTERED
LAND SURVEYOR S-2582

DATE: SEPT. 10, 2013 JOB NO. 13.902

ZGW-1

007-2996