


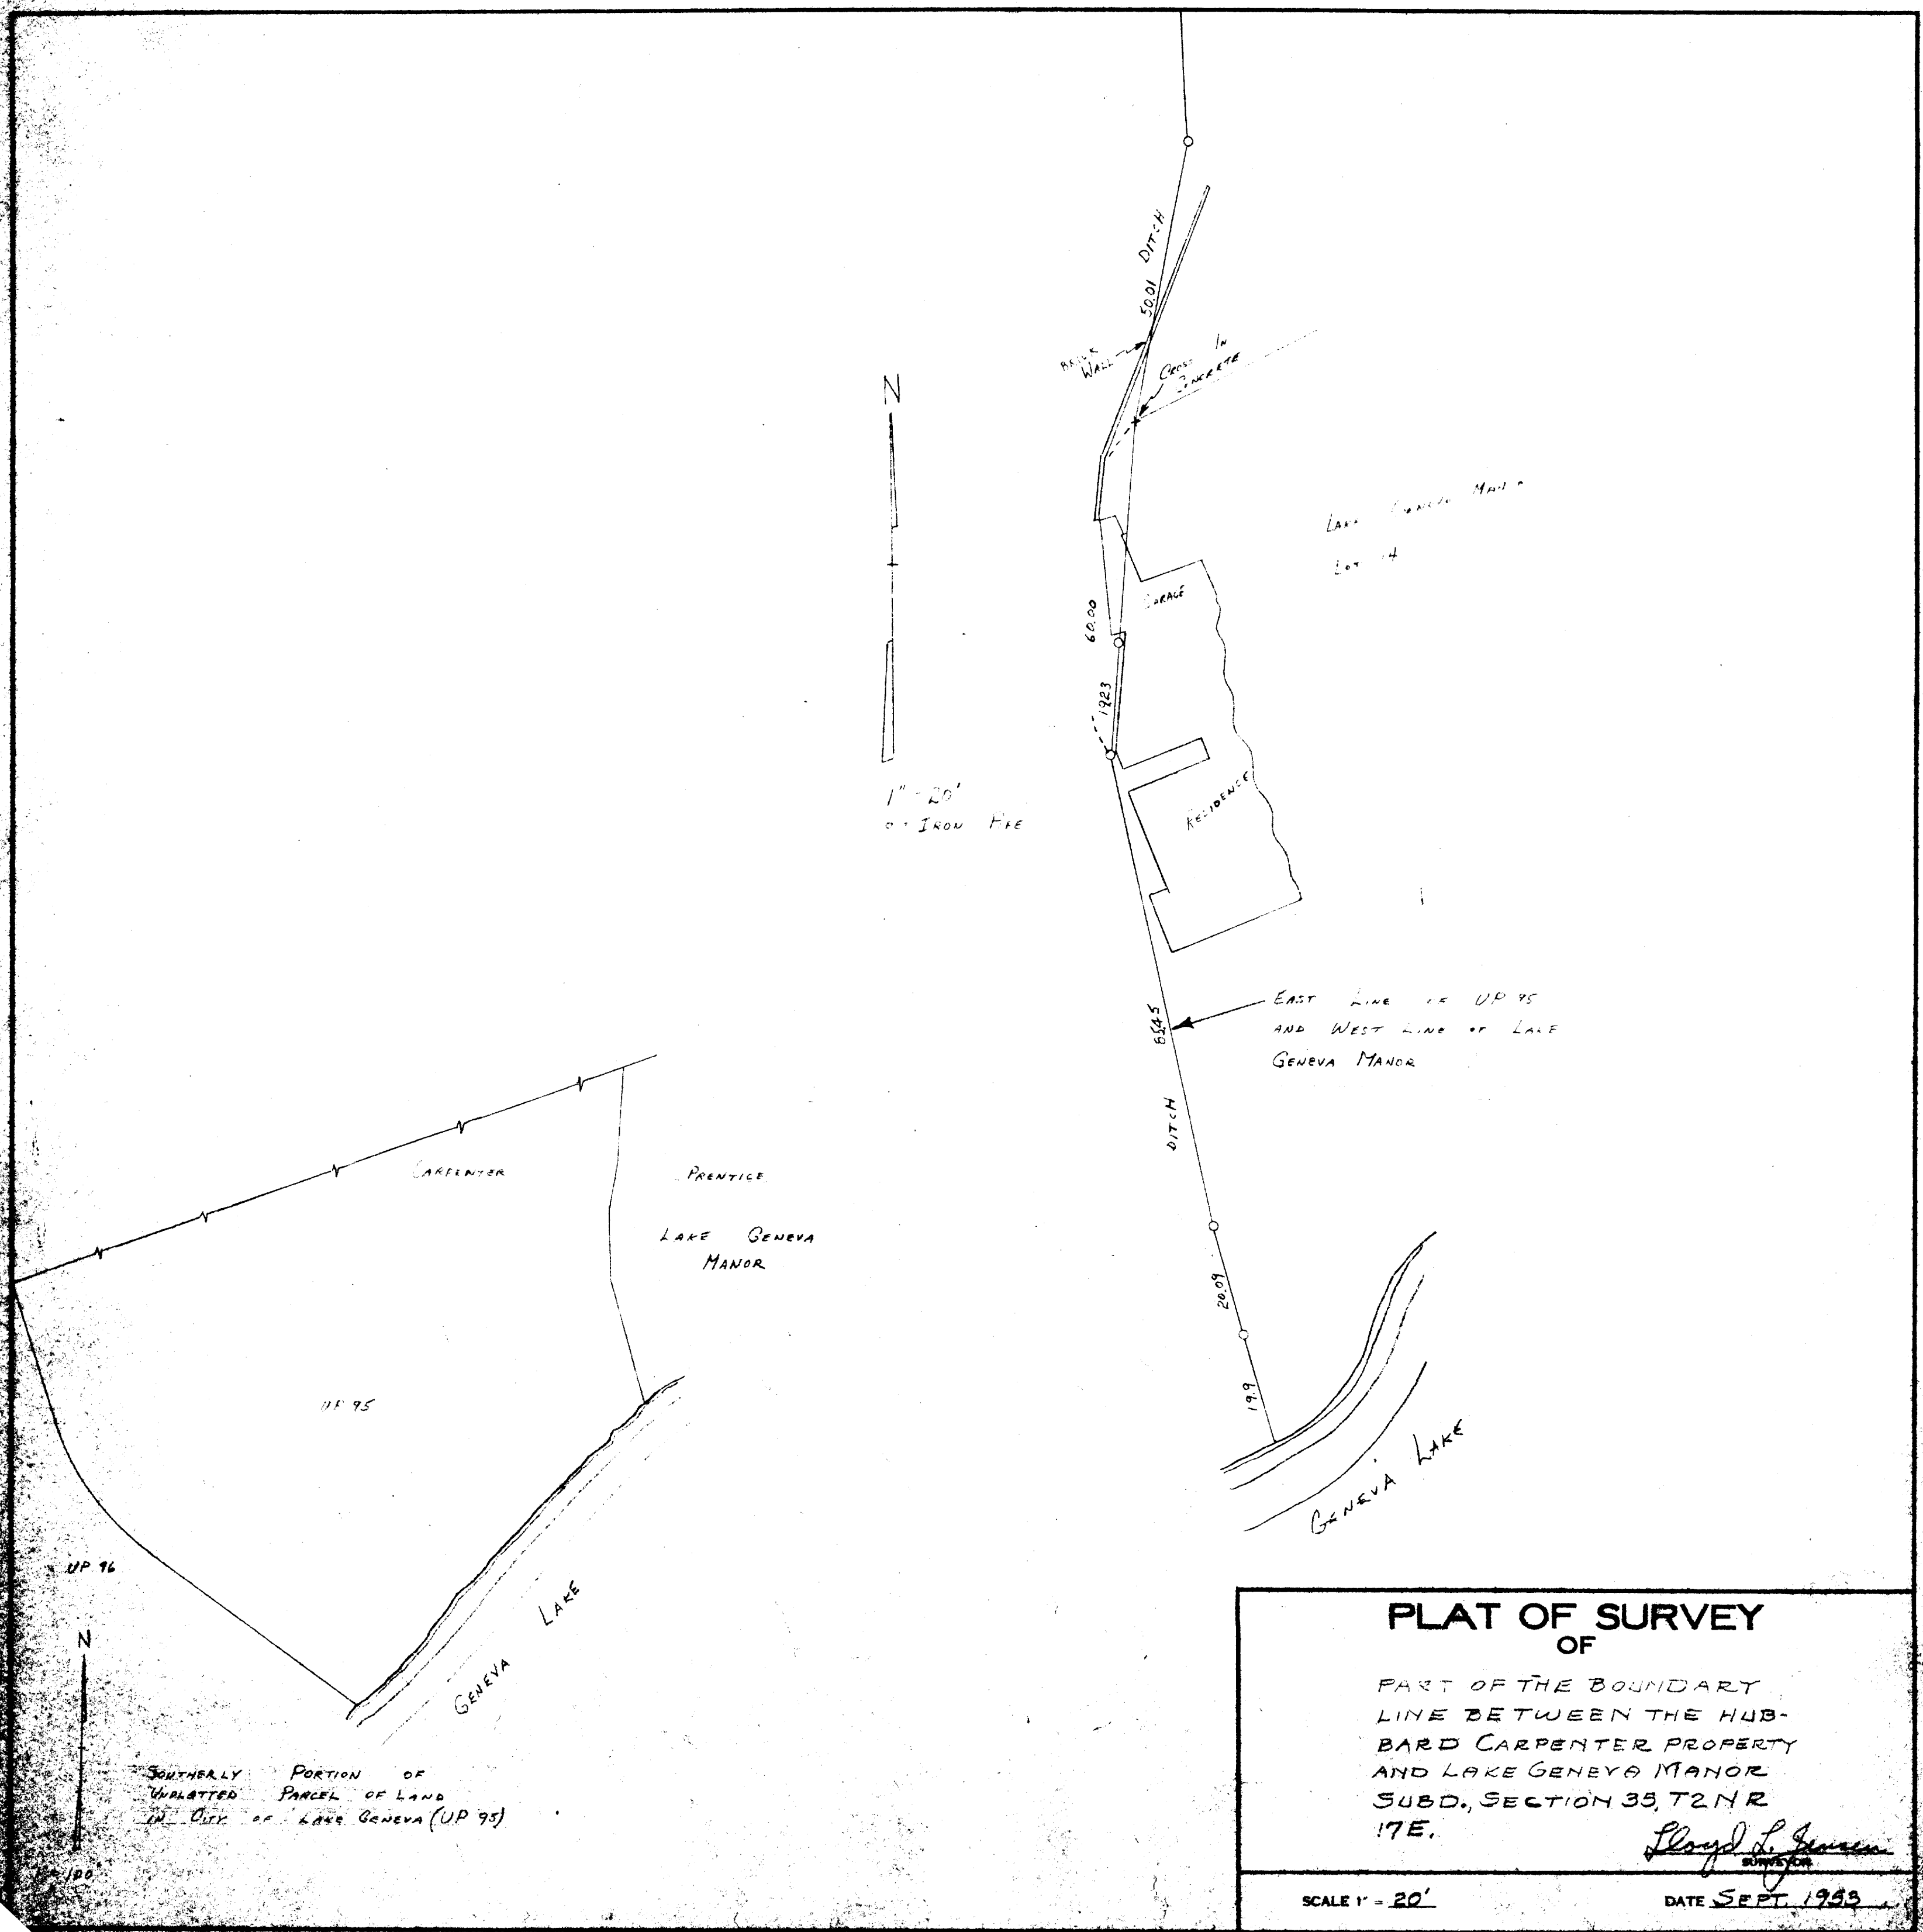

PLAT OF SURVEY
OF

PART OF THE BOUNDARY
LINE BETWEEN THE HUB-
BARD CARPENTER PROPERTY
AND LAKE GENEVA MANOR
SUBD., SECTION 35, T2N R
17E.

Lloyd L. Jensen
Surveyor

SCALE 1" = 20'

DATE SEPT 1993

7-29-J