
OF SURVEY

PATHFINDER SURVEYING INC.
(formerly)
J.K. SURVEYING INC.
P.O BOX 322
LAKE GENEVA, WI. 53147
WWW.PATHFINDERSURVEYING.NET
262-248-8303

THE SOUTH 91.00 FEET OF LOT 45, FERGUSONS ADDITION TO THE VILLAGE (NOW CITY) OF LAKE GENEVA, LOCATED IN THE SOUTH 1/2 OF THE EAST 1/2 OF THE EAST 1/2 OF THE SOUTHWEST 1/4 OF SECTION 25, TOWNSHIP 2 NORTH, RANGE 17 EAST, CITY OF LAKE GENEVA, WALWORTH COUNTY, WISCONSIN.

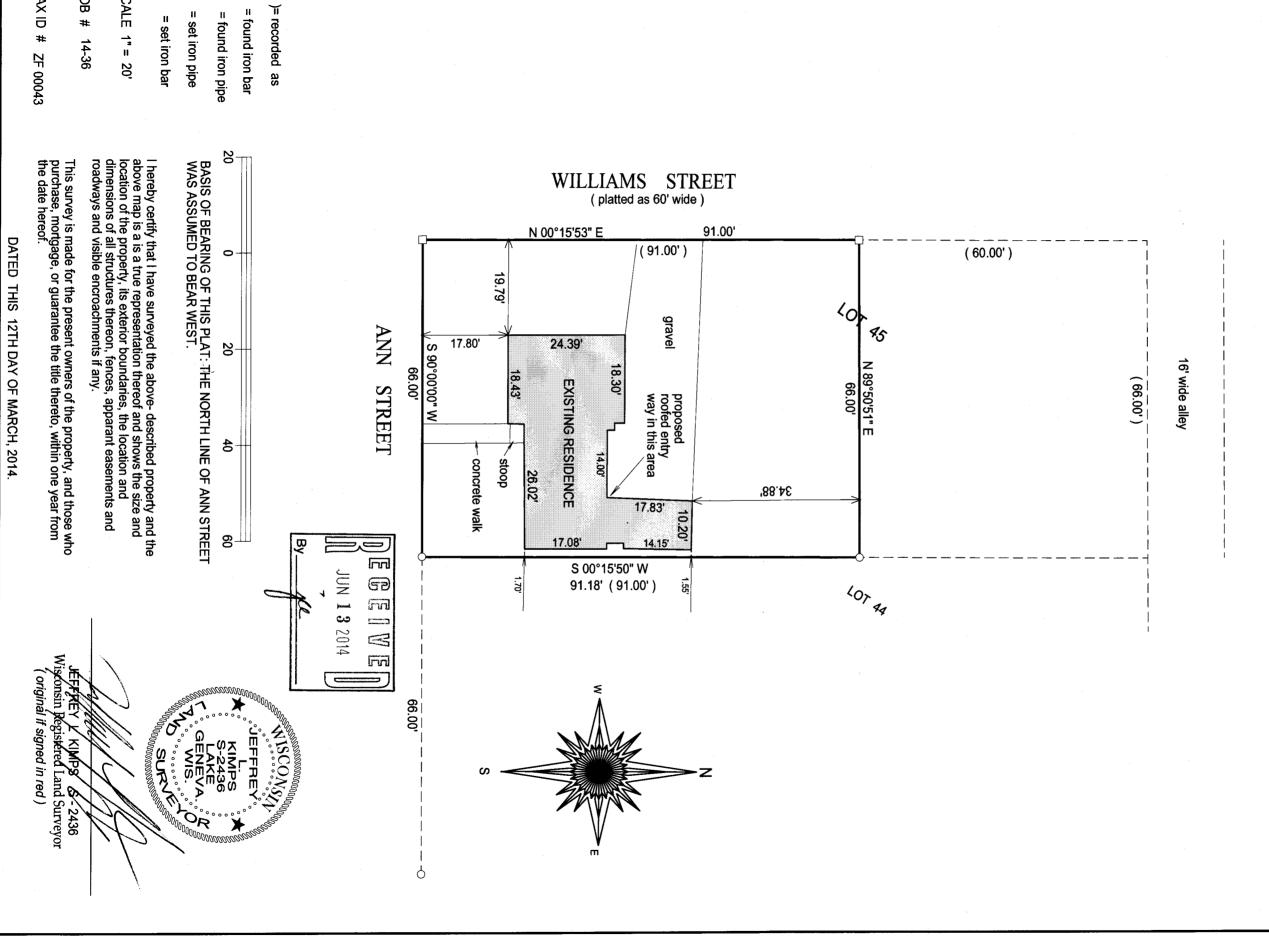

SCALE

JOB #

TAX ID

#

3047