


PLAT OF SURVEY
UNIT 13 OF SOMERSET CONDOMINIUM
LOCATED IN PART OF THE NORTHWEST 1/4 OF SECTION 1
TOWN 1 NORTH, RANGE 17 EAST, CITY OF LAKE GENEVA, WALWORTH COUNTY, WISCONSIN

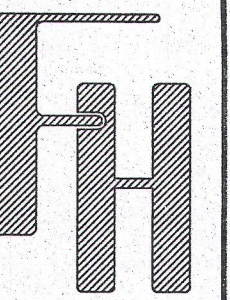



HAPP RESIDENCE

WORK ORDERED BY -
LARRY HAPP
506 BANBURY ROAD
MUNDELEIN, IL 60060

FARRIS, HANSEN & ASSOCIATES, INC.
ENGINEERING - ARCHITECTURE - SURVEYING
7 RIDGWAY COURT P.O. BOX 437
ELKHORN, WISCONSIN 53121
OFFICE: (262) 723-2098 FAX: (262) 723-5886

REVISIONS
07/31/2015 - DSR
PER CLIENT COMMENTS
02/25/2016 - KB
TO SHOW SIZE & LOC.
OF AS-BUILT RESIDENCE

PROJECT NO.
9316
DATE
7/6/2015
SHEET NO.
1 OF 1

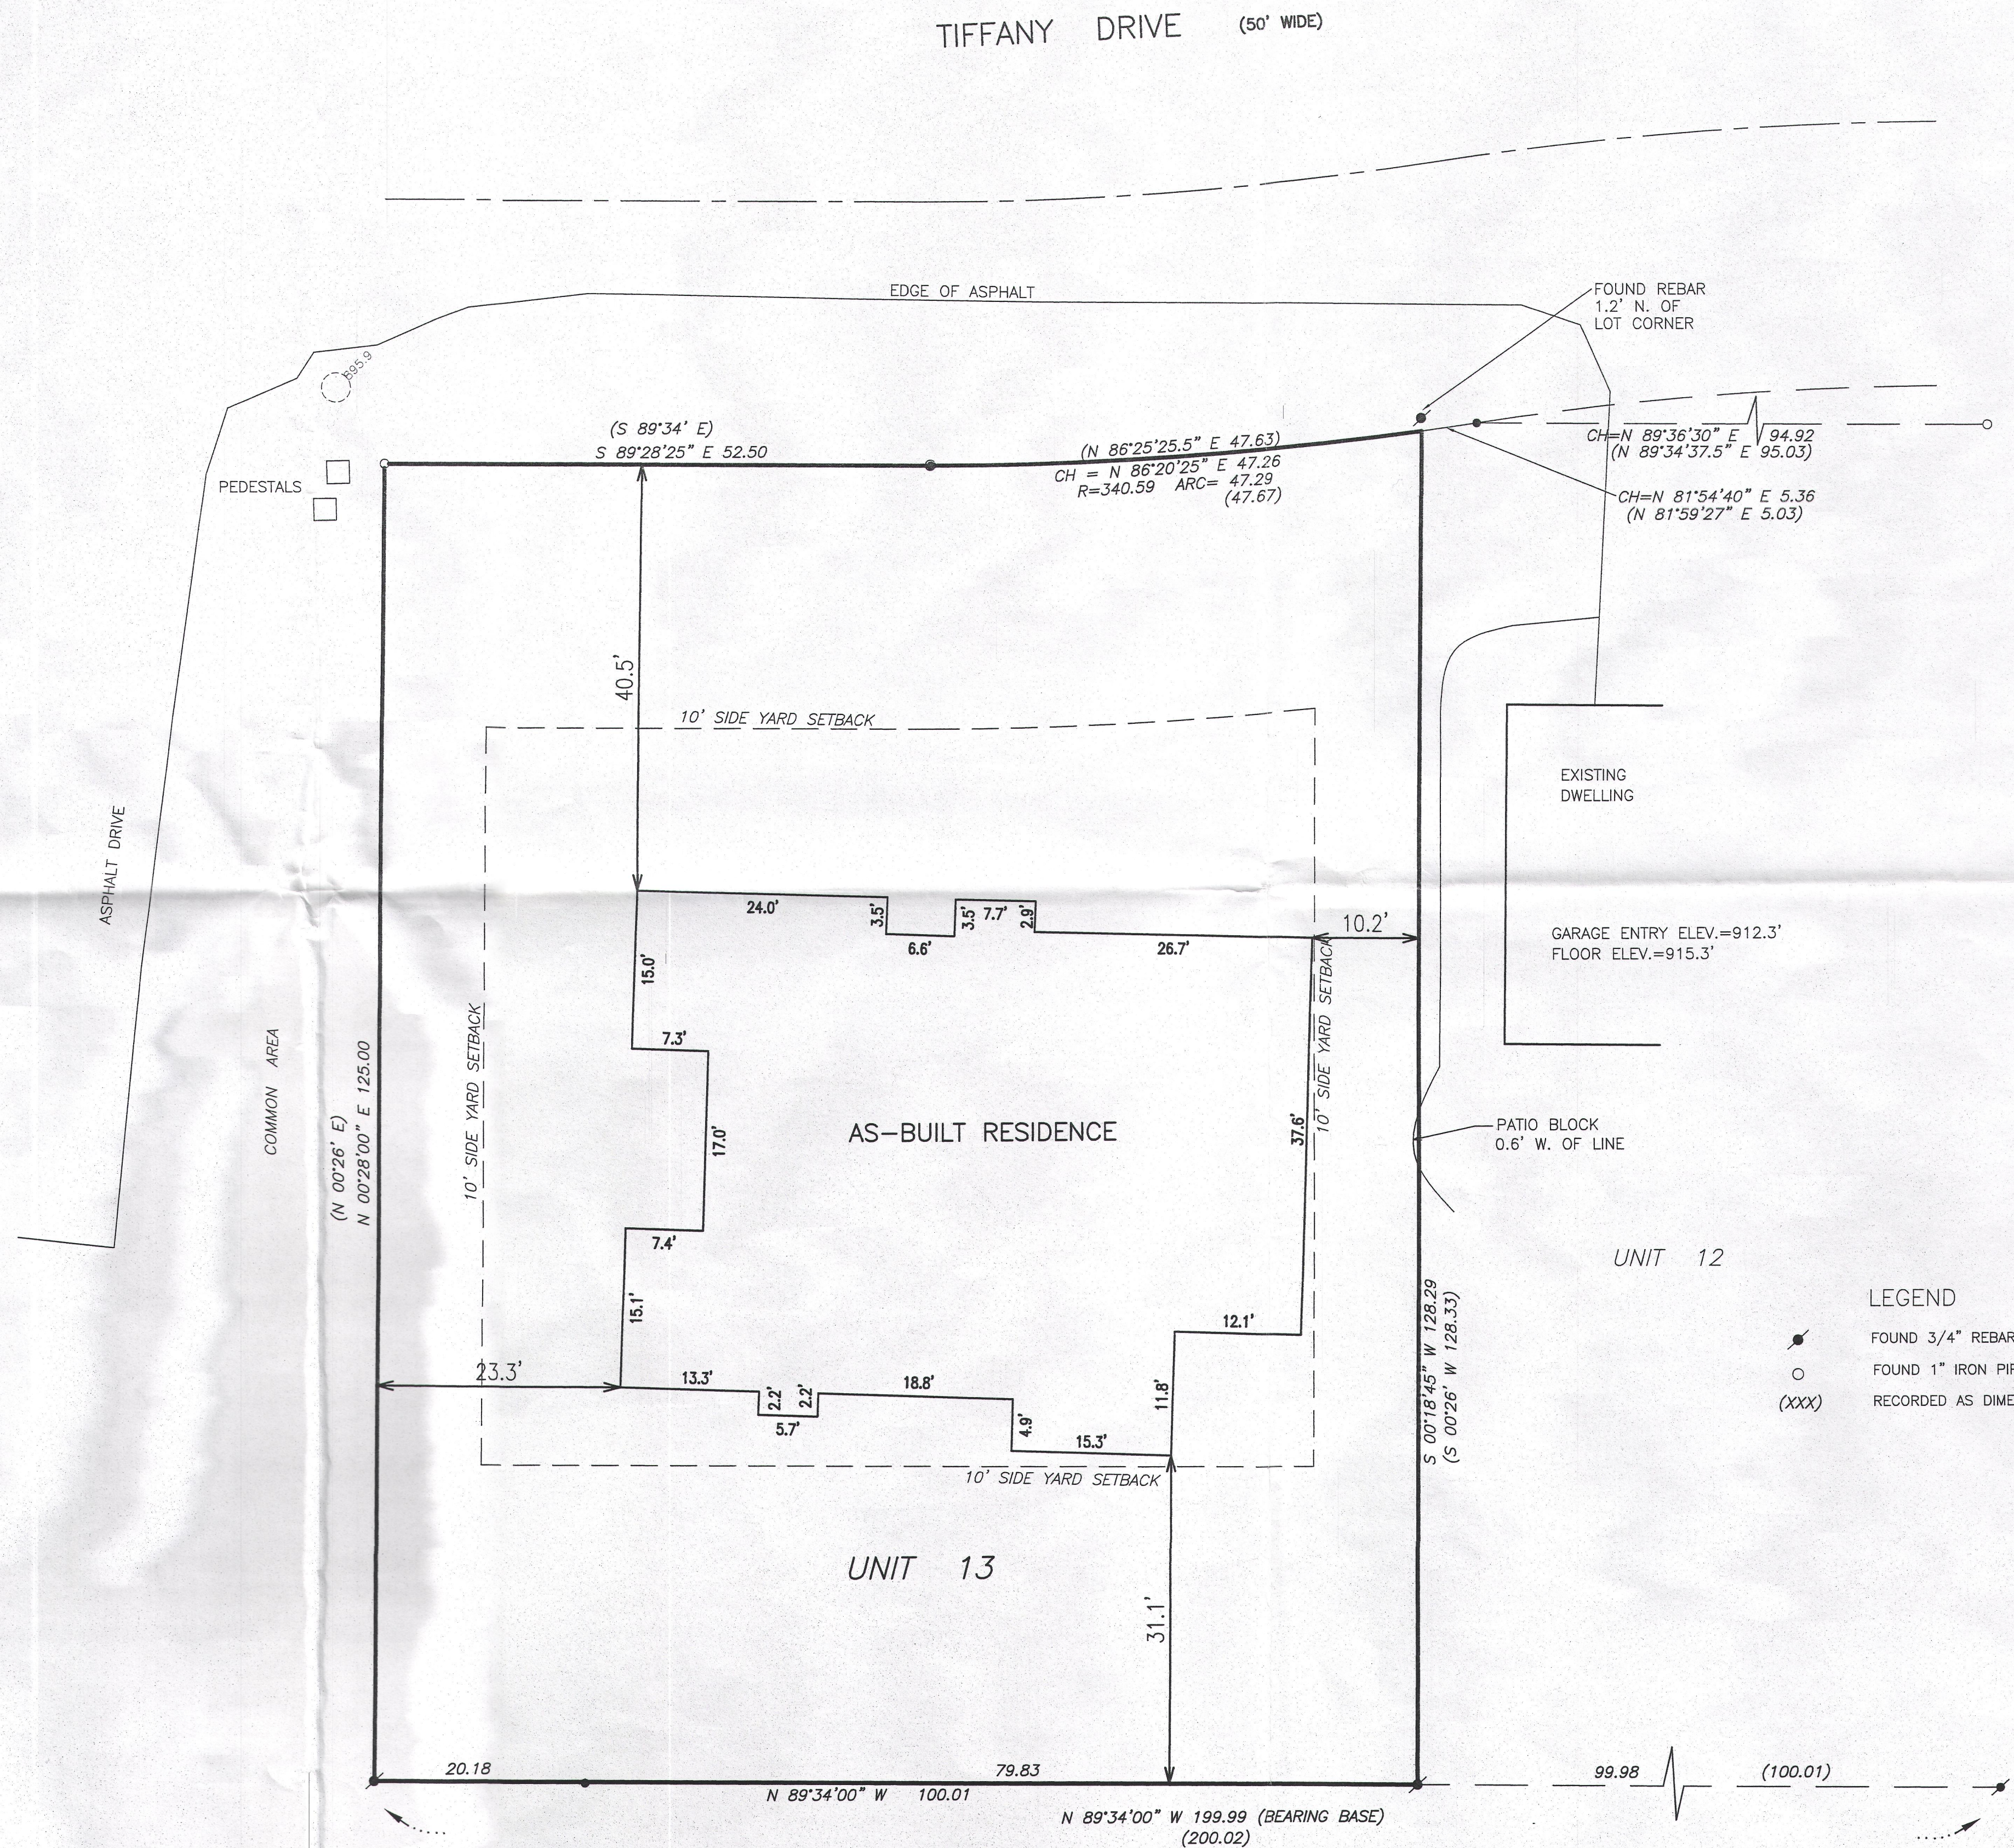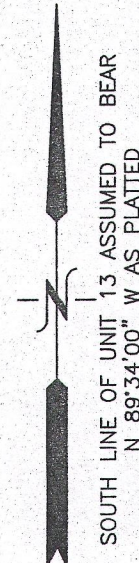



LEGEND
● FOUND 3/4\" REBAR
○ FOUND 1\" IRON PIPE
(xxx) RECORDED AS DIMENSION

NOTE: COPIES OF THIS MAP TO WHICH THE FOLLOWING CERTIFICATE WILL APPLY SHOW THE SURVEYOR'S ORIGINAL SEAL AND SIGNATURE IN RED INK. COPIES BY ANY OTHER MEANS MAY HAVE ALTERATIONS WHICH DO NOT REPRESENT THE SURVEYOR'S WORK PRODUCT.

I HEREBY CERTIFY THAT THE ABOVE DESCRIBED PROPERTY HAS BEEN SURVEYED UNDER MY DIRECTION AND THAT THE ABOVE MAP IS A TRUE REPRESENTATION THEREOF AND SHOWS THE SIZE AND LOCATION OF THE PROPERTY AND ITS EXTERIOR BOUNDARIES. THIS SURVEY IS MADE FOR THE USE OF THE PRESENT OWNERS OF THE PROPERTY, AND ALSO THOSE WHO PURCHASE, MORTGAGE, OR GUARANTEE THE TITLE THERETO WITHIN ONE YEAR FROM THE DATE HEREOF.


DATED: JULY 6, 2015

PETER S. GORDON P.L.S. 2101

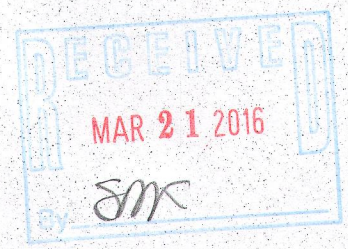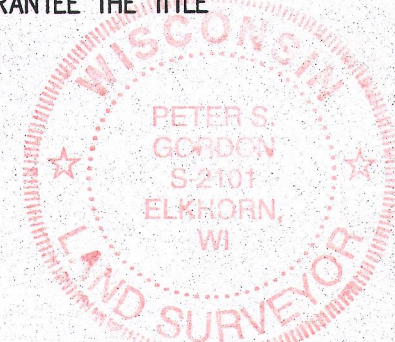

FEB 26 2016

X:\Projects\150316\ACAD\9316_SDCP

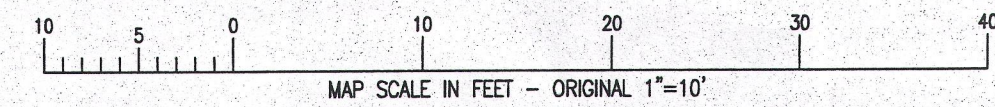

20NS-13

007-3236