
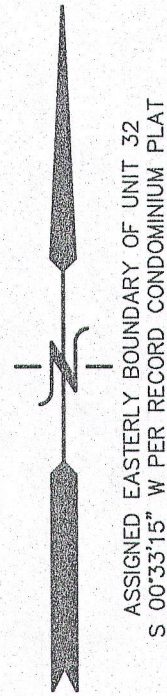


MAR 04 2016


3/4/2016 X:\Projects\8684\DCAD\SURVEY

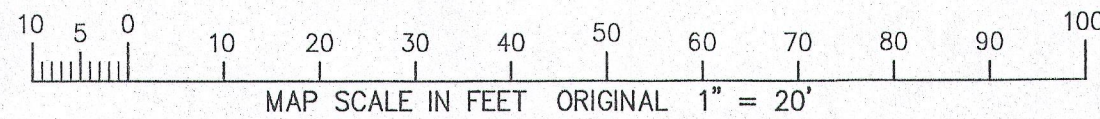

PLAT OF SURVEY

UNIT 32 OF SOMERSET CONDOMINIUM

LOCATED IN PART OF THE NORTHWEST 1/4 OF SECTION 1, TOWN 1 NORTH,
RANGE 17 EAST, CITY OF LAKE GENEVA, WALWORTH COUNTY, WISCONSIN

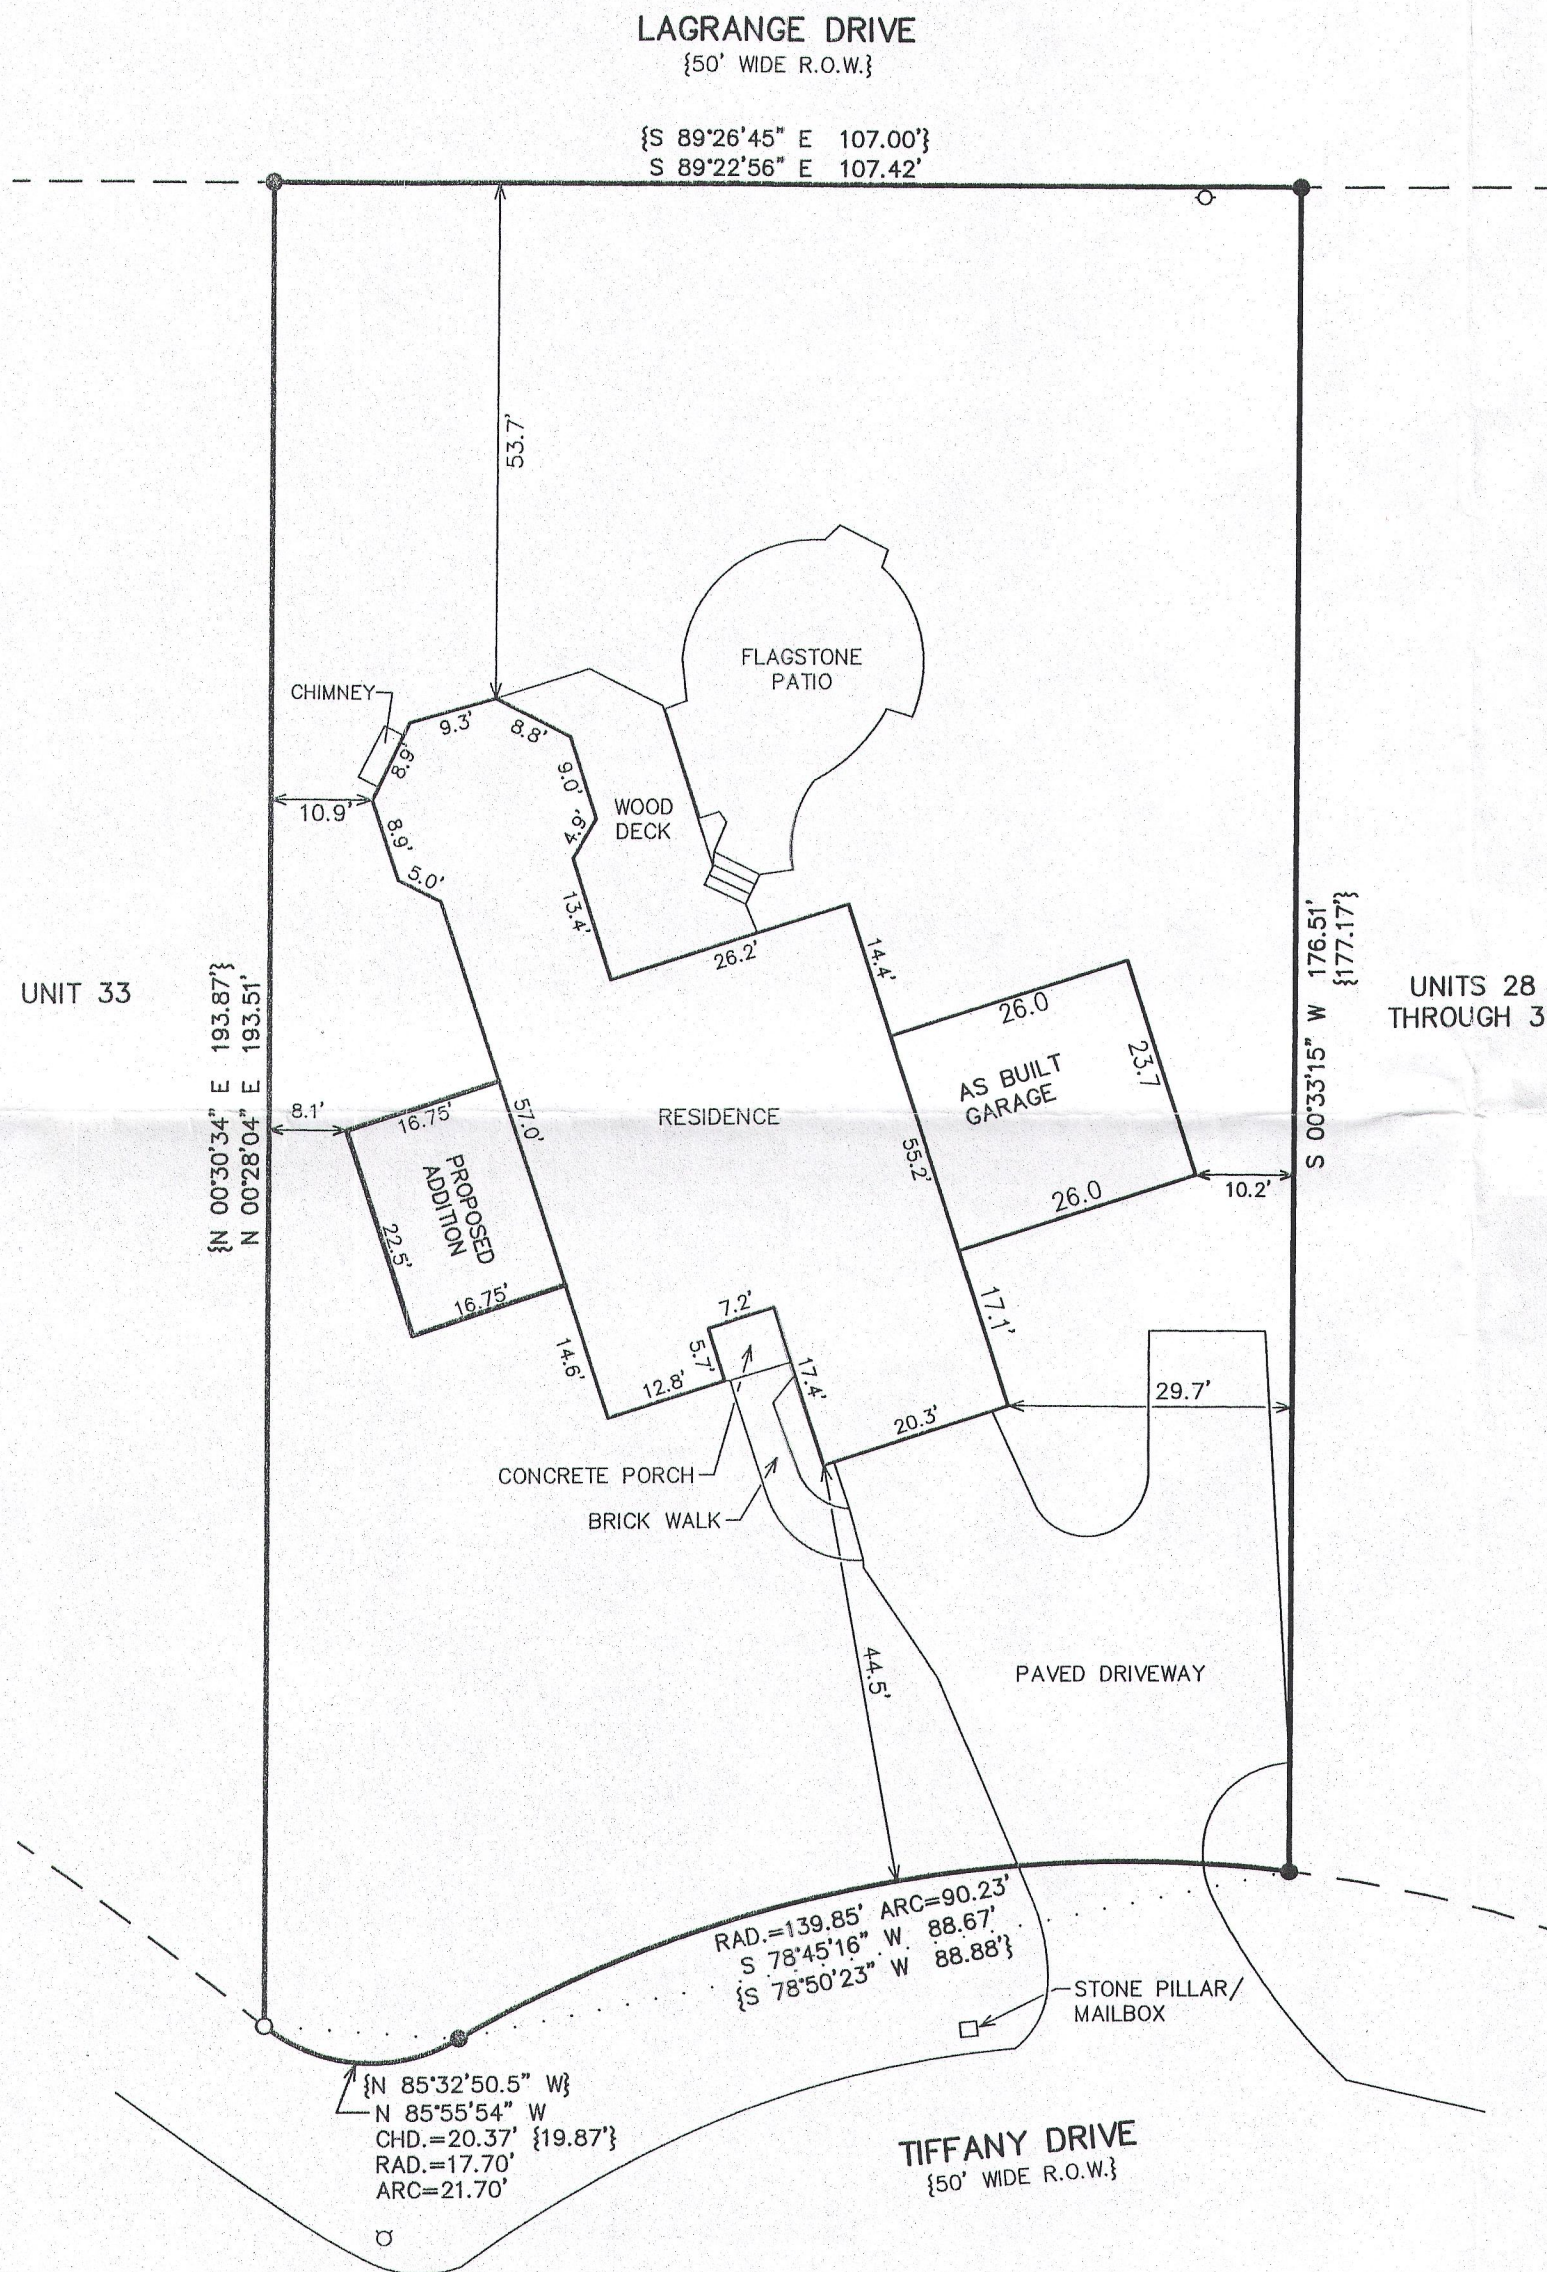

- LEGEND
- = FOUND IRON PIPE STAKE
 - = FOUND IRON REBAR STAKE
 - ⊕ = HYDRANT LOCATED
 - ⊙ = UTILITY POLE LOCATED
 - {XXX} = RECORDED AS

NOTE: COPIES OF THIS MAP TO WHICH THE FOLLOWING CERTIFICATE WILL APPLY SHOW THE SURVEYOR'S ORIGINAL SEAL AND SIGNATURE IN RED INK. COPIES BY ANY OTHER MEANS MAY HAVE ALTERATIONS WHICH DO NOT REPRESENT THE SURVEYOR'S WORK PRODUCT.

I HEREBY CERTIFY THAT THE ABOVE DESCRIBED PROPERTY HAS BEEN SURVEYED UNDER MY DIRECTION AND THAT THE ABOVE MAP IS A TRUE REPRESENTATION THEREOF AND SHOWS THE SIZE AND LOCATION OF THE PROPERTY AND ITS EXTERIOR BOUNDARIES. THIS SURVEY IS MADE FOR THE USE OF THE PRESENT OWNERS OF THE PROPERTY, AND ALSO THOSE WHO PURCHASE, MORTGAGE, OR GUARANTEE THE TITLE THERETO WITHIN ONE YEAR FROM THE DATE HEREOF.

DATED: 10/16/2012

REVISED 03-04-2016
TO SHOW SIZE & LOCATION OF
PROPOSED ADDITION

Peter S. Gordon
PETER S. GORDON R.L.S. 2101



PLAT OF SURVEY

CITY OF LAKE GENEVA, WALWORTH COUNTY, WI

— WORK ORDERED BY —
MIKE McNULTY
1020 S. LAKESHORE DRIVE #32
LAKE GENEVA, WI.

FARRIS, HANSEN & ASSOCIATES, INC.
ENGINEERING — ARCHITECTURE — SURVEYING
7 RIDGWAY COURT P.O. BOX 437
ELKHORN, WISCONSIN 53121
OFFICE: (262) 723-2098 FAX: (262) 723-5886

REVISIONS

PROJECT NO.
8684
DATE:
10/16/2012
SHEET NO.
1 OF 1

ZCNS - 33

007-3238