



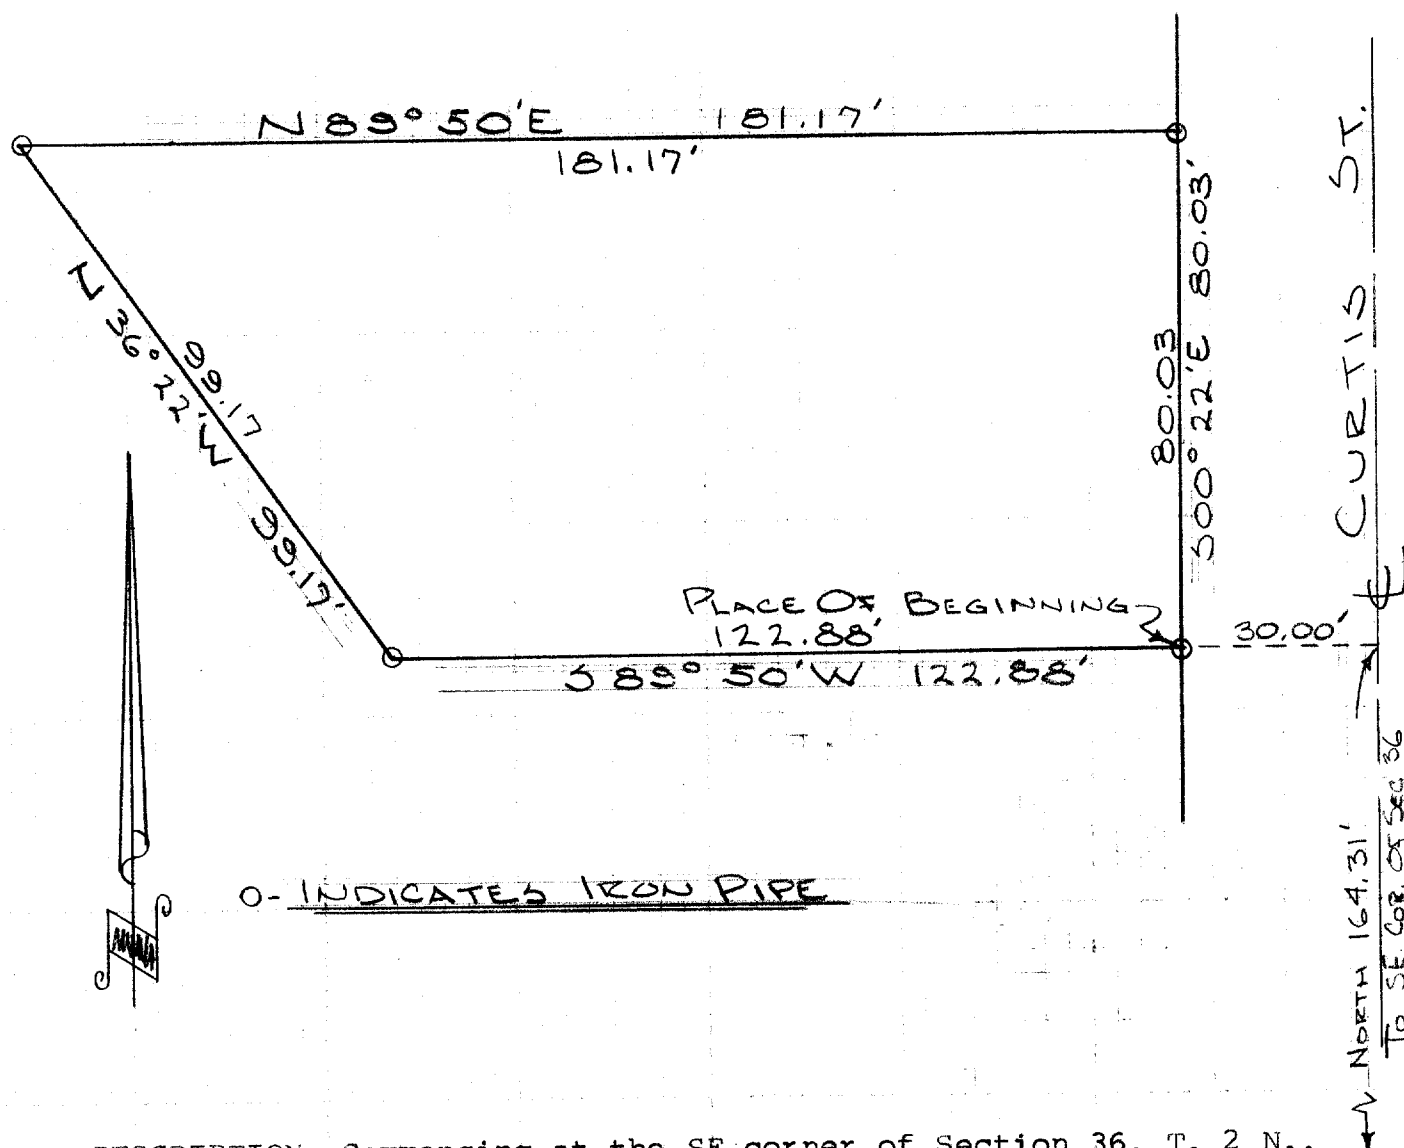

DESCRIPTION: Commencing at the SE corner of Section 36, T. 2 N., R. 17 E., City of Lake Geneva, Walworth County, Wisconsin; thence North along the center line of Curtis Street 164.31 feet, thence S. 89° 50' W. parallel to the South Section line, 30.00 feet to the place of beginning of the lands hereinafter described, to wit: thence continue S. 89° 50' W. 122.88 feet, thence N. 36° 22' W. 99.17 feet, thence N. 89° 50' E. 181.17 feet to the west line of Curtis Street, thence S. 00° 22' E. along said line 80.03 feet to the place of beginning.

CERTIFICATE: I, James F. Biagi, surveyor, do hereby certify that I have surveyed the property hereon described.

April 16, 1970

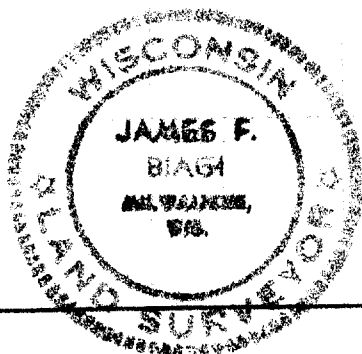

James F. Biagi, R.L.S. 272

#7-111B.2
7-330

OP-399I