


47

Survey for

McKinley Hodge ~~Plot~~ 5 Block
10. original village



17

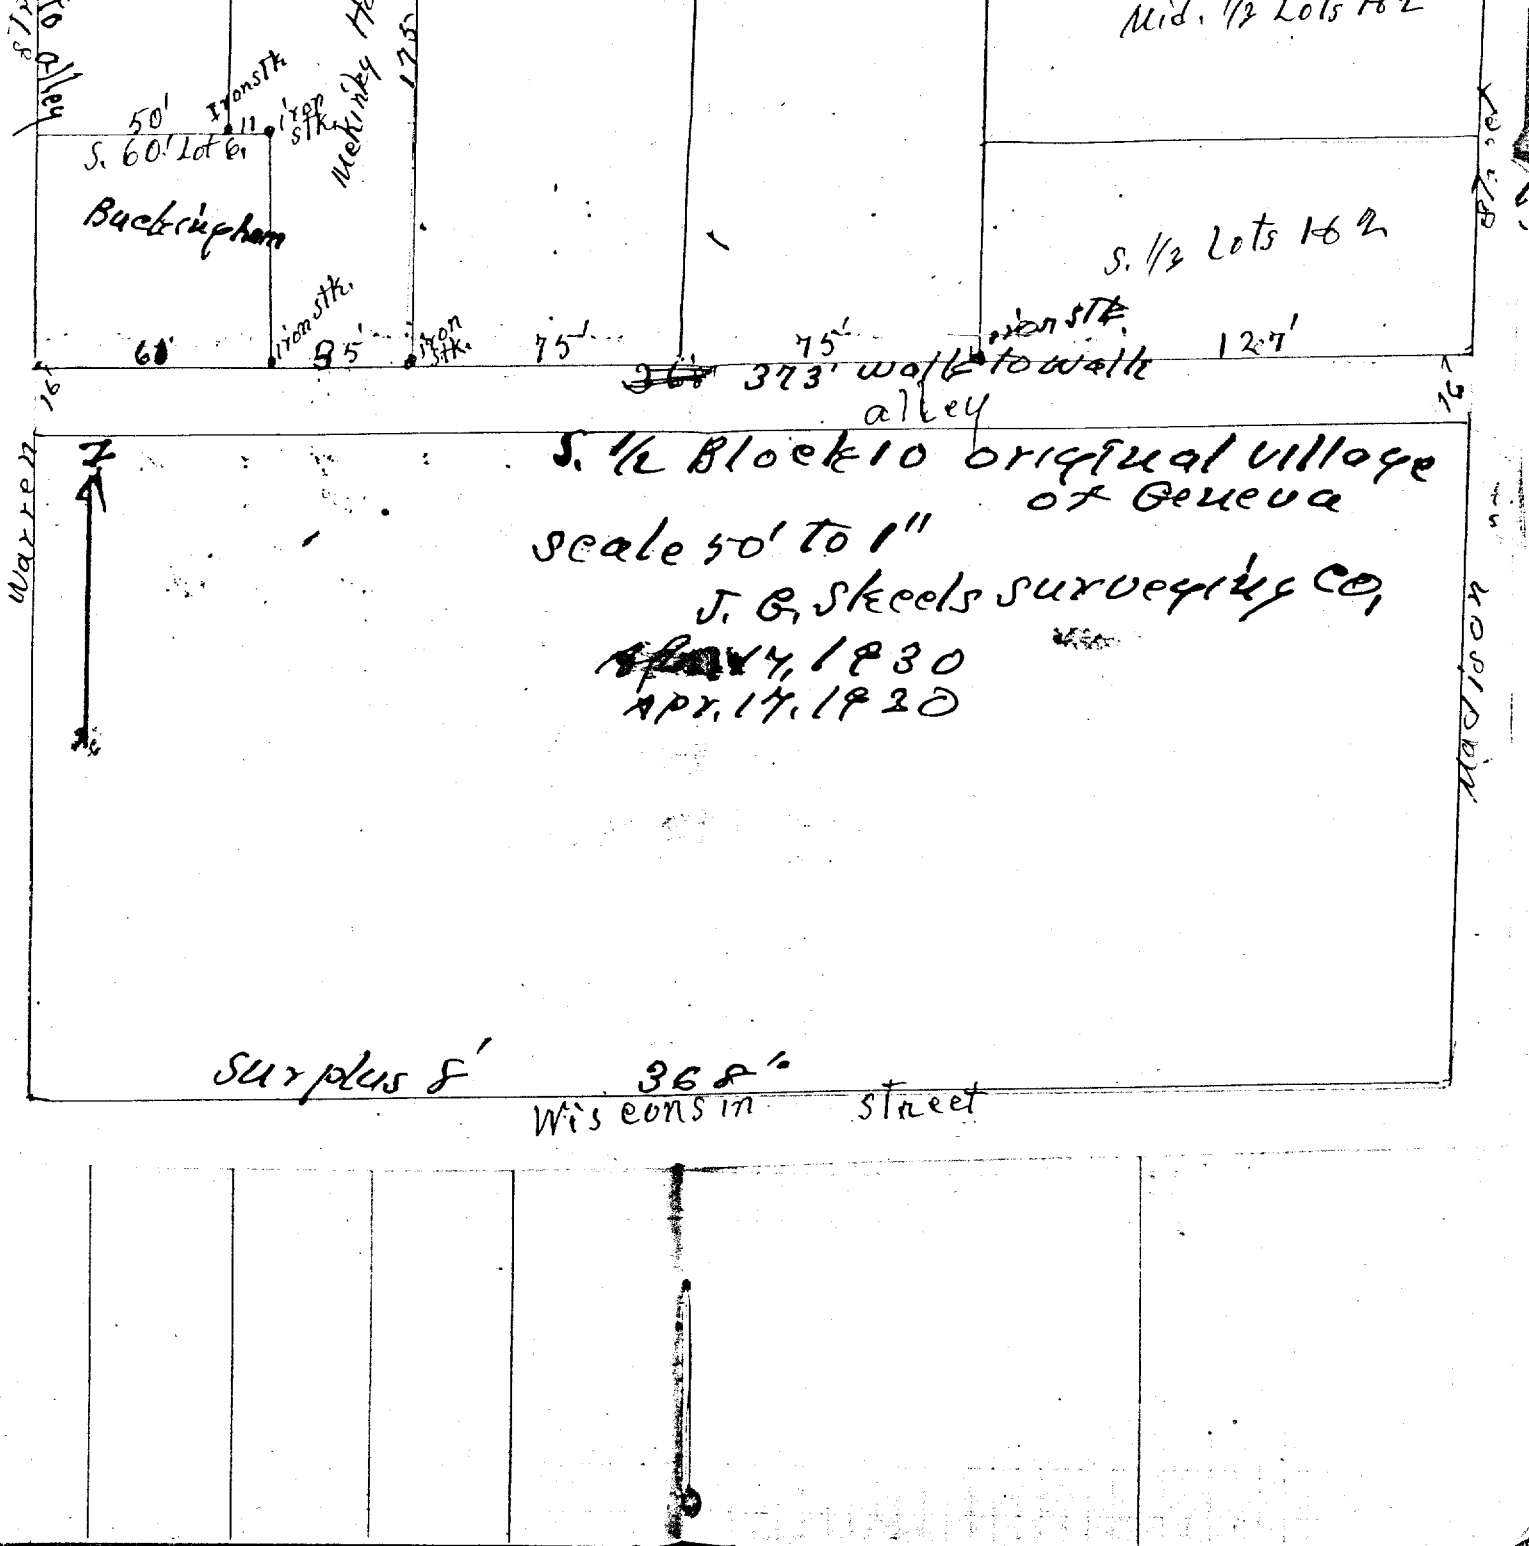

Buckingham

S. 60' Lot 6

S. 1/2 Lots 16 & 17

Mid. 1/2 Lots 16 & 17

S. 1/2 Block 10 original village of Geneva

Scale 50' to 1"

J. B. Steels Surveying Co.

May 4, 1930

Apr. 17, 1920

Surplus 8'

362'

Wisconsin Street

Warren

Madison