
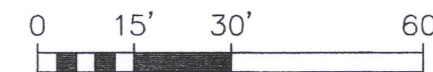


LEGEND

- FOUND IRON PIPE
- ⋈ FOUND AXLE ROD
- SET IRON PIPE
- () RECORDED AS

BEARINGS HEREON RELATE TO THE SOUTH LINE OF THE SURVEYED PROPERTY. ASSUMED BEARING OF EAST AS DEEDED.

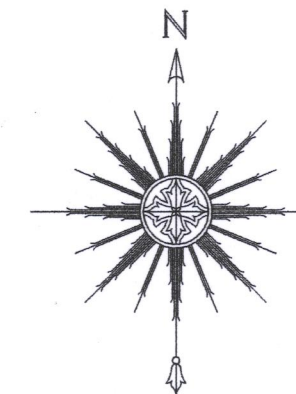

SCALE: 1" = 30'

**PLAT OF SURVEY
-OF-**



PART OF THE SOUTHWEST 1/4 OF SECTION 25, TOWN 2 NORTH, RANGE 17 EAST, DESCRIBED AS FOLLOWS: BEGIN AT A POINT ON THE EAST LINE OF THE WEST 1/2 OF THE EAST 1/2 OF THE SOUTHWEST 1/4 OF SECTION 25, TOWN 2 NORTH, RANGE 17 EAST, WHICH IS THE CENTERLINE OF WILLIAMS STREET, 579 FEET SOUTH OF THE 1/4 LINE OF SAID SECTION; RUN THENCE WEST IN THE SOUTH LINE OF LAND OWNED BY HENRY J. MALSCH AND WIFE 30 FEET TO AN IRON STAKE AND CONTINUING IN THE SAME LINE WEST 301 FEET TO AN IRON STAKE; THENCE SOUTH PARALLEL WITH 1/16 SECTION LINE 60 FEET TO AN IRON STAKE; THENCE EAST IN ONE RUBACH'S NORTH LINE PARALLEL TO THE NORTH LINE OF THIS PARCEL 301 FEET TO AN IRON STAKE AND CONTINUING IN THE SAME LINE EAST 30 FEET TO SAID 1/16 SECTION LINE AND THE CENTER OF WILLIAMS STREET; THENCE NORTH 60 FEET TO THE POINT OF BEGINNING. SAID LAND BEING IN THE CITY OF LAKE GENEVA, COUNTY OF WALWORTH AND STATE OF WISCONSIN.

SURVEY FOR: BOB LIMOSANI OF HOMESTEAD REALTY
SURVEY ADDRESS: 1118 AND 1120 WILLIAMS STREET, LAKE GENEVA, WI 53147

"I HEREBY CERTIFY THAT I HAVE SURVEYED THE ABOVE DESCRIBED PROPERTY AND THAT THE ABOVE MAP IS A CORRECT REPRESENTATION THEREOF AND SHOWS THE SIZE AND LOCATION OF THE PROPERTY, ITS EXTERIOR BOUNDARIES, THE LOCATION OF ALL VISIBLE STRUCTURES AND DIMENSIONS OF ALL PRINCIPAL BUILDINGS THEREON, BOUNDARY FENCES, APPARENT EASEMENTS, ROADWAYS AND ENCROACHMENTS, IF ANY."

"THIS SURVEY IS MADE FOR THE USE OF THE PRESENT OWNERS OF THE PROPERTY, AND THOSE WHO PURCHASE, MORTGAGE, OR GUARANTEE THE TITLE THERETO WITHIN ONE YEAR FROM DATE HEREOF."

SATTER SURVEYING, LLC
LAND SURVEYS, MAPPING AND PLANNING
272 ORIGEN STREET
BURLINGTON, WI 53105
262-661-4239

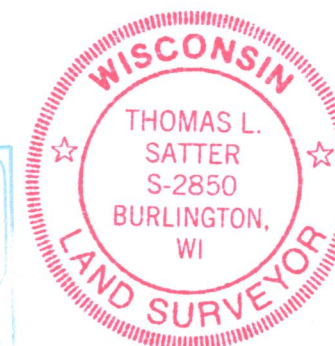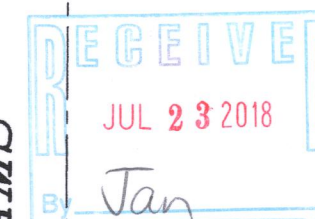

THIS IS NOT AN ORIGINAL PRINT
UNLESS THIS SEAL IS RED.

Thomas L. Satter
THOMAS L. SATTER S-2850

JULY 5, 2018
DATE

061806
JOB NUMBER

ZYUP-18

007-3478