

48

6/2/27


Survey for Mrs. Sweet
surveyed S. line Mrs.
Subdivision,

Found old iron stks
N. E. & N. W. cors. Lot
On W. line measured
Battistore lot 60' and
60' 17 1/2' S. to N. line
about 8" N. of N. walk

Lots 1, 2 & 3. Newberry,
set iron stks at above
Mr. Wolins of

6/2/27

~~Lot 14, Lake Geneva Villa
Found iron stks, N. W.
L. S. V. Park. from E. end
laid off piece in N. &
lined in and set iron
Willow St. line making
E. line 50' S. line 184.2~~

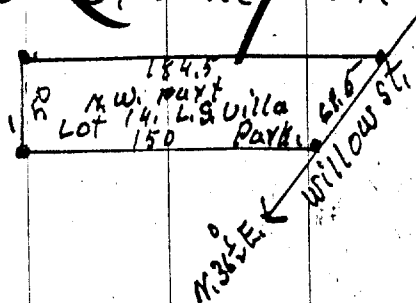

request R. Soutar
Sweet's 1st Lot N. of Newberry

N. E. Cor. Lot 1 Newberry

3.

S. from iron stks S. W. Cor.
measured from S. end of
Cass St. Checked O. K.
line Cass St same as

Price \$1.50

point

Chicago. 50' x 150' N. W. Cor.

Park.

~~N. E. S. E. & S. W. corners Lot
Lot 14. above. (Lot 1825 x 79.2')
Cor. 32 1/2 S. W. by 50' N. & S.
stks at W. points and at
N. line of tract laid off 150'
W. line 61.5'~~

Price \$3.50

7-349-2k ✓