


-OF-

SURVEY FOR: JOE COLE
SURVEY ADDRESS: 1175 LASALLE COURT, LAKE GENEVA, WI 53147

NOTE: REFER TO A CURRENT TITLE REPORT
FOR EASEMENTS, RESTRICTIONS OR COVENANTS
WHICH MAY AFFECT THIS PROPERTY.

NOTE: ALL OF THE FOUND MONUMENTS
ARE BELIEVED TO BE THE ORIGINAL
C.S.M. MONUMENTS ARE WERE ACCEPTED
AS THE PROPERTY CORNERS.

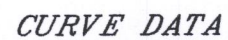


RADIUS = 50.00'
CENTRAL ANGLE = 98°11'21"
CHORD = 75.58'
CHORD BEARING = S76°52'39"W (S76°48'39"W)

Note: This map is being revised this 1st day of December, 2018 to depict the existing dwelling under construction and show its proximity to the property lines. All other property details are from initial survey work.

LEGEND

- o FOUND 1-5/16" O.D. IRON PIPE
 x FOUND 3/4" DIA. IRON ROD
 x FOUND 1-1/4" DIA. IRON ROD
 • SET 1" DIA. IRON ROD
 () RECORDED AS
 100.0 EXISTING ELEVATION

BEARINGS HEREON RELATE TO THE WEST
LINE OF LOT 4 OF CERTIFIED SURVEY
MAP NO. 4248. ASSUMED BEARING OF
NORTH 01°00'29" EAST AS PLATTED.

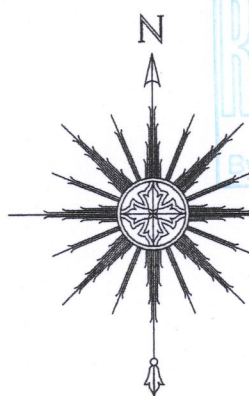

DEC 19 2018



THIS IS NOT AN ORIGINAL PRINT
UNLESS THIS SEAL IS RED.

Thomas L. Satter

REVISED: 12/1/18
MARCH 9, 2018
DATE

021809
JOB NUMBER

"I HEREBY CERTIFY THAT I HAVE SURVEYED THE ABOVE DESCRIBED PROPERTY AND THAT THE ABOVE MAP IS A CORRECT REPRESENTATION THEREOF AND SHOWS THE SIZE AND LOCATION OF THE PROPERTY, ITS EXTERIOR BOUNDARIES, THE LOCATION OF ALL VISIBLE STRUCTURES AND DIMENSIONS OF ALL PRINCIPAL BUILDINGS THEREON, BOUNDARY FENCES, APPARENT EASEMENTS, ROADWAYS AND ENCROACHMENTS, IF ANY."

"THIS SURVEY IS MADE FOR THE USE OF THE PRESENT OWNERS OF THE PROPERTY, AND THOSE WHO PURCHASE, MORTGAGE, OR GUARANTEE THE TITLE THERETO WITHIN ONE YEAR FROM DATE HEREOF."

SATTER SURVEYING, LLC
LAND SURVEYS, MAPPING AND PLANNING
272 ORIGEN STREET
BURLINGTON, WI 53105
262-661-4239

0 15' 30' 60'

SCALE: 1" = 30'

Z A 4248-4

007-3529