
PLAT OF SURVEY -OF-

LOTS 26 AND 27 OF "SYVER-STAD LAKE SHORE ESTATES", A SUBDIVISION LOCATED IN THE NORTHEAST 1/4 OF THE NORTHWEST 1/4 AND IN THE NORTHWEST 1/4 OF THE NORTHEAST 1/4 OF SECTION 1, TOWNSHIP 1 NORTH, RANGE 17 EAST OF THE FOURTH PRINCIPAL MERIDIAN, IN THE CITY OF LAKE GENEVA, COUNTY OF WALWORTH AND STATE OF WISCONSIN.

SURVEY FOR: ANN ESARCO

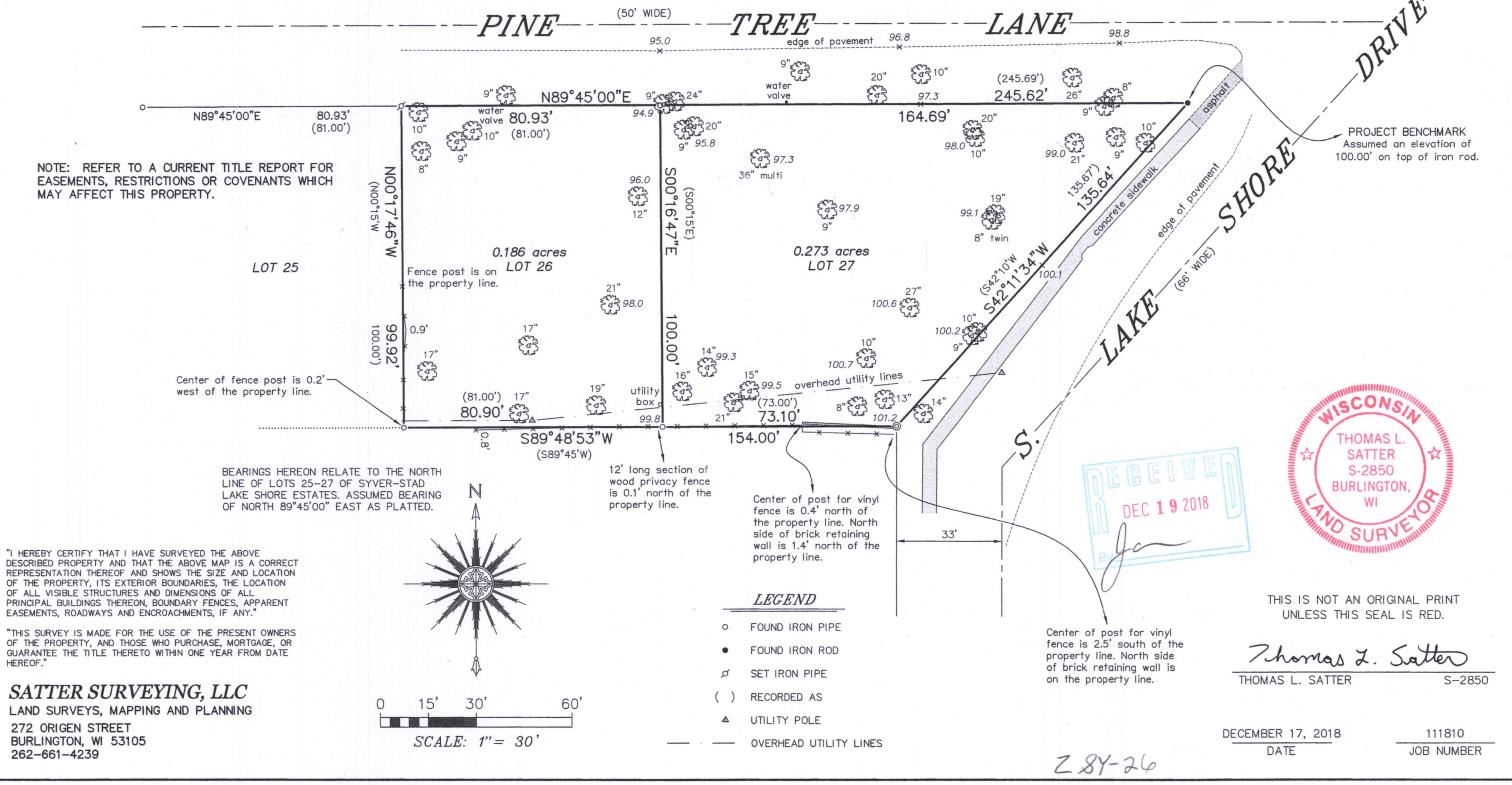

2 84-27

007-3531