

## Wisconsin Professional Land Surveyor S-2582


**N9330 Knuteson Drive  
Whitewater, WI 53190  
Phone:(262)949-1239  
MARKMIRITZ@  
LAND-MARKSURVEYING.COM**



### LEGAL DESCRIPTION

LOCATED IN THE SOUTHEAST 1/4 OF THE SOUTHEAST 1/4, SECTION 36,  
TOWNSHIP 2 NORTH, RANGE 17 EAST, IN THE CITY OF LAKE GENEVA,  
WALWORTH COUNTY, WISCONSIN.

UNIT 207, SUMMERHAVEN OF LAKE GENEVA ADDENDUM NO. 2

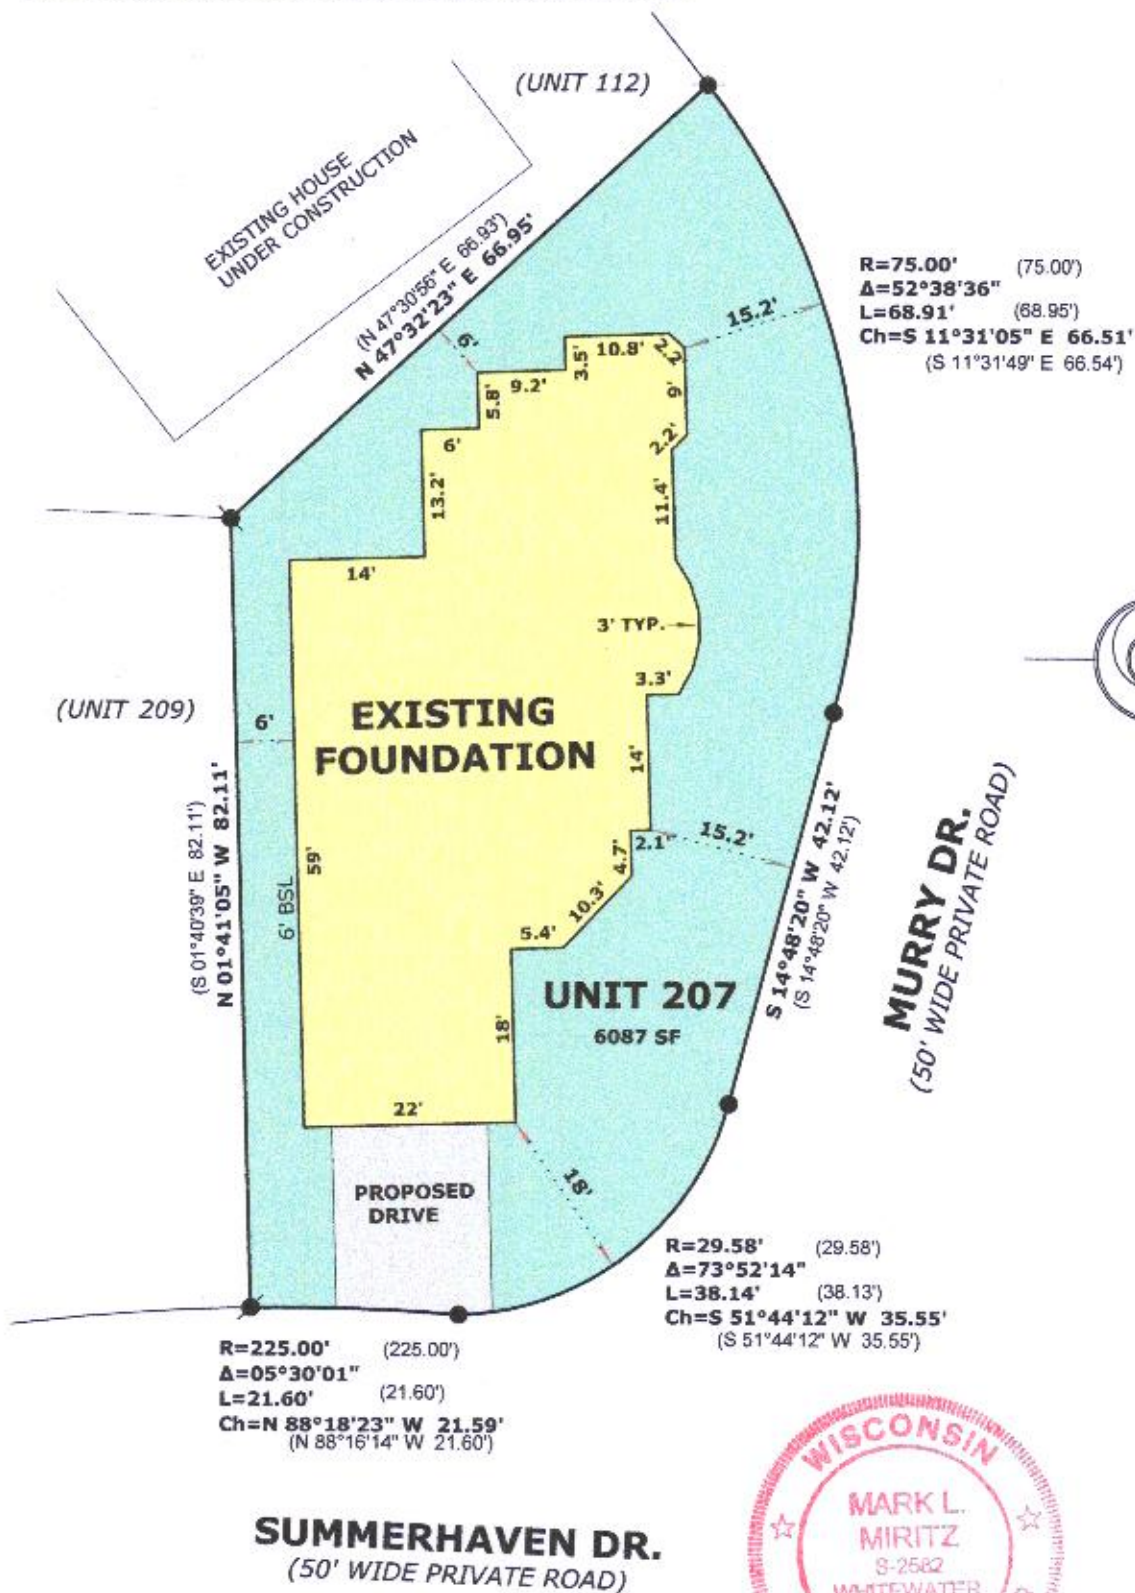

**SCALE: 1 INCH = 20 FEET**

"I hereby certify that the above described property has been surveyed by me or under my direction and that the above map is a true representation thereof and shows the size and location of the property, its exterior boundaries, the location of all visible structures and dimensions of all principal buildings thereon, boundary fences, apparent easements, roadways and visible encroachments, if any."

"This survey is made for the use of the present owners of the property, and also those who purchase, mortgage, or guarantee the title thereto within one year from date hereof."

*Mark L. Miritz*  
 MARK L. MIRITZ  
 WISCONSIN PROFESSIONAL  
 LAND SURVEYOR S-2582

DATE: September 15, 2019 JOB NO. 19.911

## LEGEND

- FOUND IRON ROD
- SET IRON ROD, 18" LONG, WEIGHING  
1.5 LBS./LINEAL FT., 3/4" DIA.
- ( x x ) RECORDED AS DIMENSION

**ORDERED BY:**  
Basso Builders Inc.  
405 Skyline Dr.  
Lake Geneva, WI 53147

REVISED FEB. 22, 2020 TO  
SHOW FOUNDATION "AS BUILT"

ZSUM-207

007-3730