


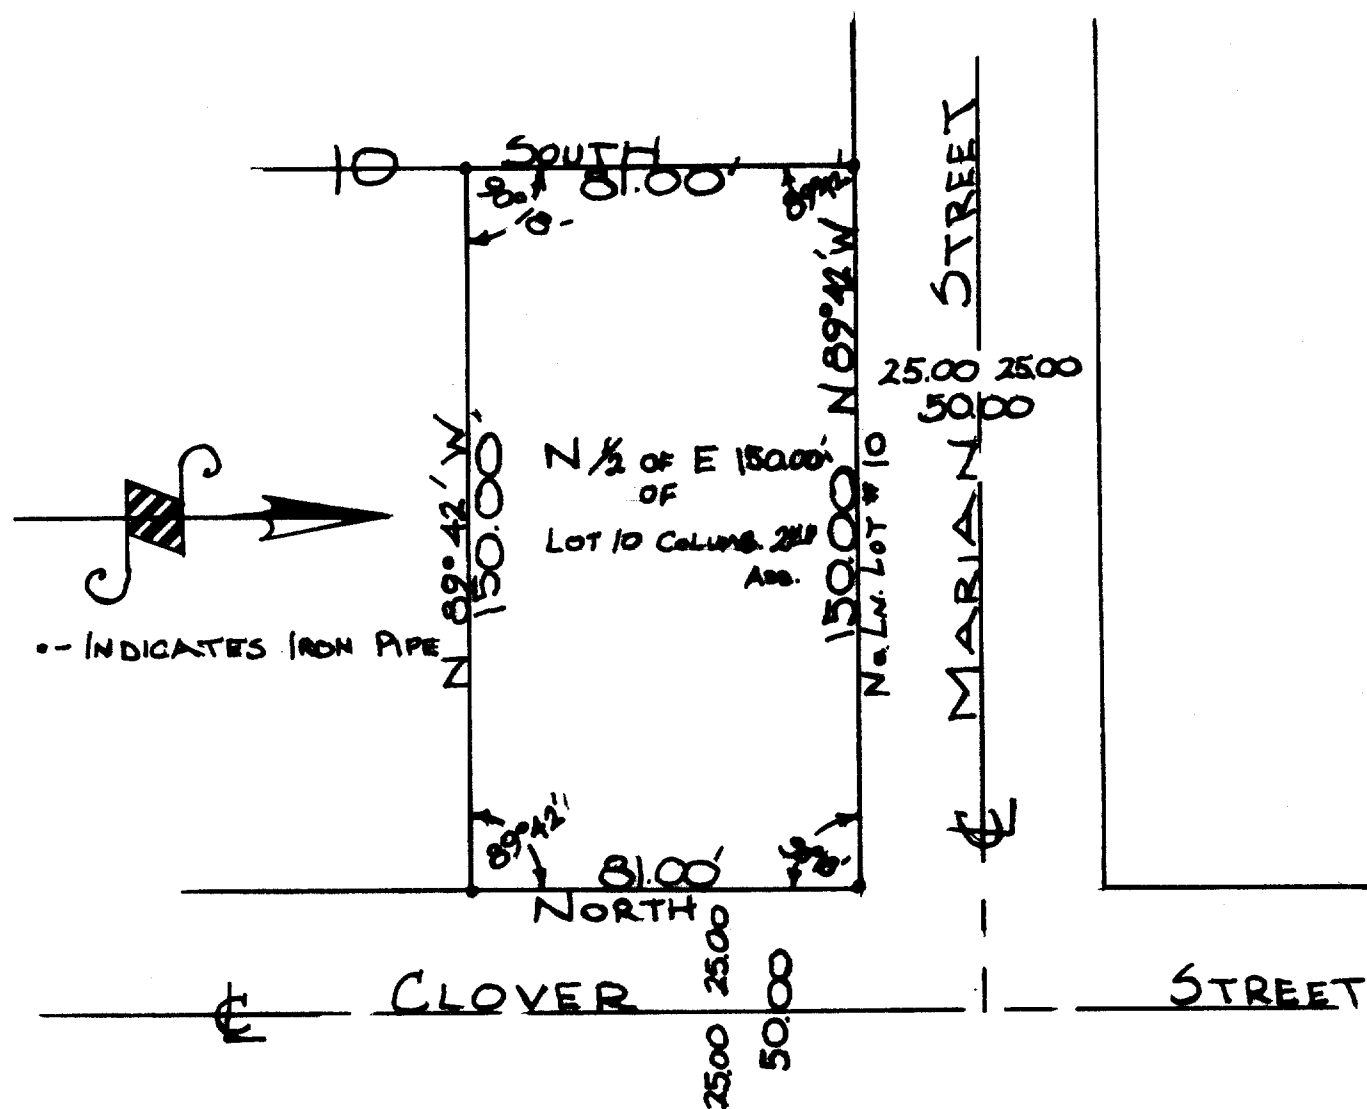


DESCRIPTION:

The south one-half of the east one hundred fifty feet of Lot 10, of Columbian 2nd Subdivision in the City of Lake Geneva, Walworth County, Wisconsin.

CERTIFICATE:

I, hereby certify, that I, James F. Biagi, have surveyed the property hereon described, on this the 25th day of November, 1961.

Signed and sealed on this the 25th day of November 1961.

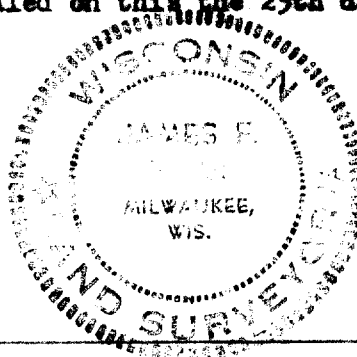

James F. Biagi. (RLS 272)
Elkhorn, Wisconsin.