
HAROLD N. KOLB

REGISTERED PROFESSIONAL LAND SURVEYOR LAKE GENEVA, WISCONSIN

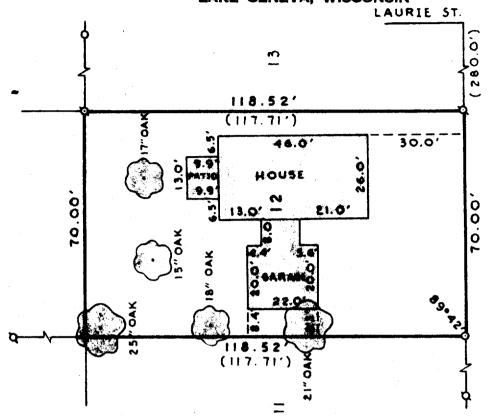

LAKE GENEVA BOULEVARD 60'

PLAT OF SURVEY OF

N

Lot 12, H. E. Wells Addition to the City of Lake Geneva, Walworth County, Wisconsin.

SCALE : 1":30"

LECEND

φ - IRON PIPE FOUND

0 - IRON PIPE PLACED

• - CONCRETE MONUMENT

X - SPIKE

() - AS PLATTED



I. HAROLD H. KOLB, DO HEREBY CERTIFY THAT I HAVE SURVEYED THE PROPERTY HEREON DESCRIBED ACCORDING TO THE OFFICIAL RECORDS, AND THAT THE PLAT HEREON IS A CORRECT REPRESENTATION OF THE LOT LINES.

Harold H. Kolf

HAROLD H. KOLB WISCONSIN REGISTERED LAND SURVEYOR, S-187

DATE July 27, 1972

7-399